IREDELL COUNTY HEALTH DEPARTMENT

STATESVILLE 704-878-5305 195.00 Paid MOORESVILLE 704-664-5281

IMPROVEMENT PERMIT / AUTHORIZATION TO CONSTRUCT / OPERATION PERMIT / EXISTING SYSTEM INSPECTION

PERMIT# 12283820 PIN# 4637 35 1618.000 DATE 7/14/05

OWNER OR CONTRACTOR Drew Shott, T. Whalen Home PHONE: Business 704-799-6666 Ex. 5 Home 704-895-7924

ADDRESS 20811 Decora Dr. Cornelius, NC. 28031

LOCATION 303 Whippoorwill Rd.

SUBDIVISION CL+T BLOCK / SECTION 10 LOT 39 LOT AREA ~1AC SITE CLASS. PS DESIGN FLOW 480 L.T.A.R. .3

Septic Tank: 1000 Gallons; STB 794 Date 5/26/08
Pump Tank: 1000 Gallons; PT 283 Date 6/14/08
Pump Make: MYERS Model ME50S-21-50 Serial No. 1108
Nitrification Field: No Fields 1 Square Feet 810 Linear Feet 270
No Lines 3@90' Trench Width 3' Max Trench Bottom Depth 3' Gravel Depth NA

☒ New System ☐ Repair System Type: I, II, III, (IV), V, VI
System Description: Pres Dosed-16" PPBPS
Repair System Description: < 1983
Maintenance Agreement Required: ☒ Yes ☐ No

☒ House/Mod. Home ☐ Mobile Home ☐ Business ☐ Other
No. Bedrooms 4 No. Bathrooms 4 No. Employees


☐ Slab ☒ Crawl Space ☐ Basement w/plumbing ☐ Basement wo/plumbing

Water Supply: ☒ Individual ☐ Public ☐ Community "NEW"

Comments:/Conditions: Existing Well must be abandoned by Well Contractor. Maintenance Contract is required on this system before OP will be issued.

Comments:/Conditions: 4/15/08 Submitted revised Site plan & Floor plan MD
Well abandonment form attached
Tanks, Lines, Pressure, Dose

INITIAL SITE SKETCH

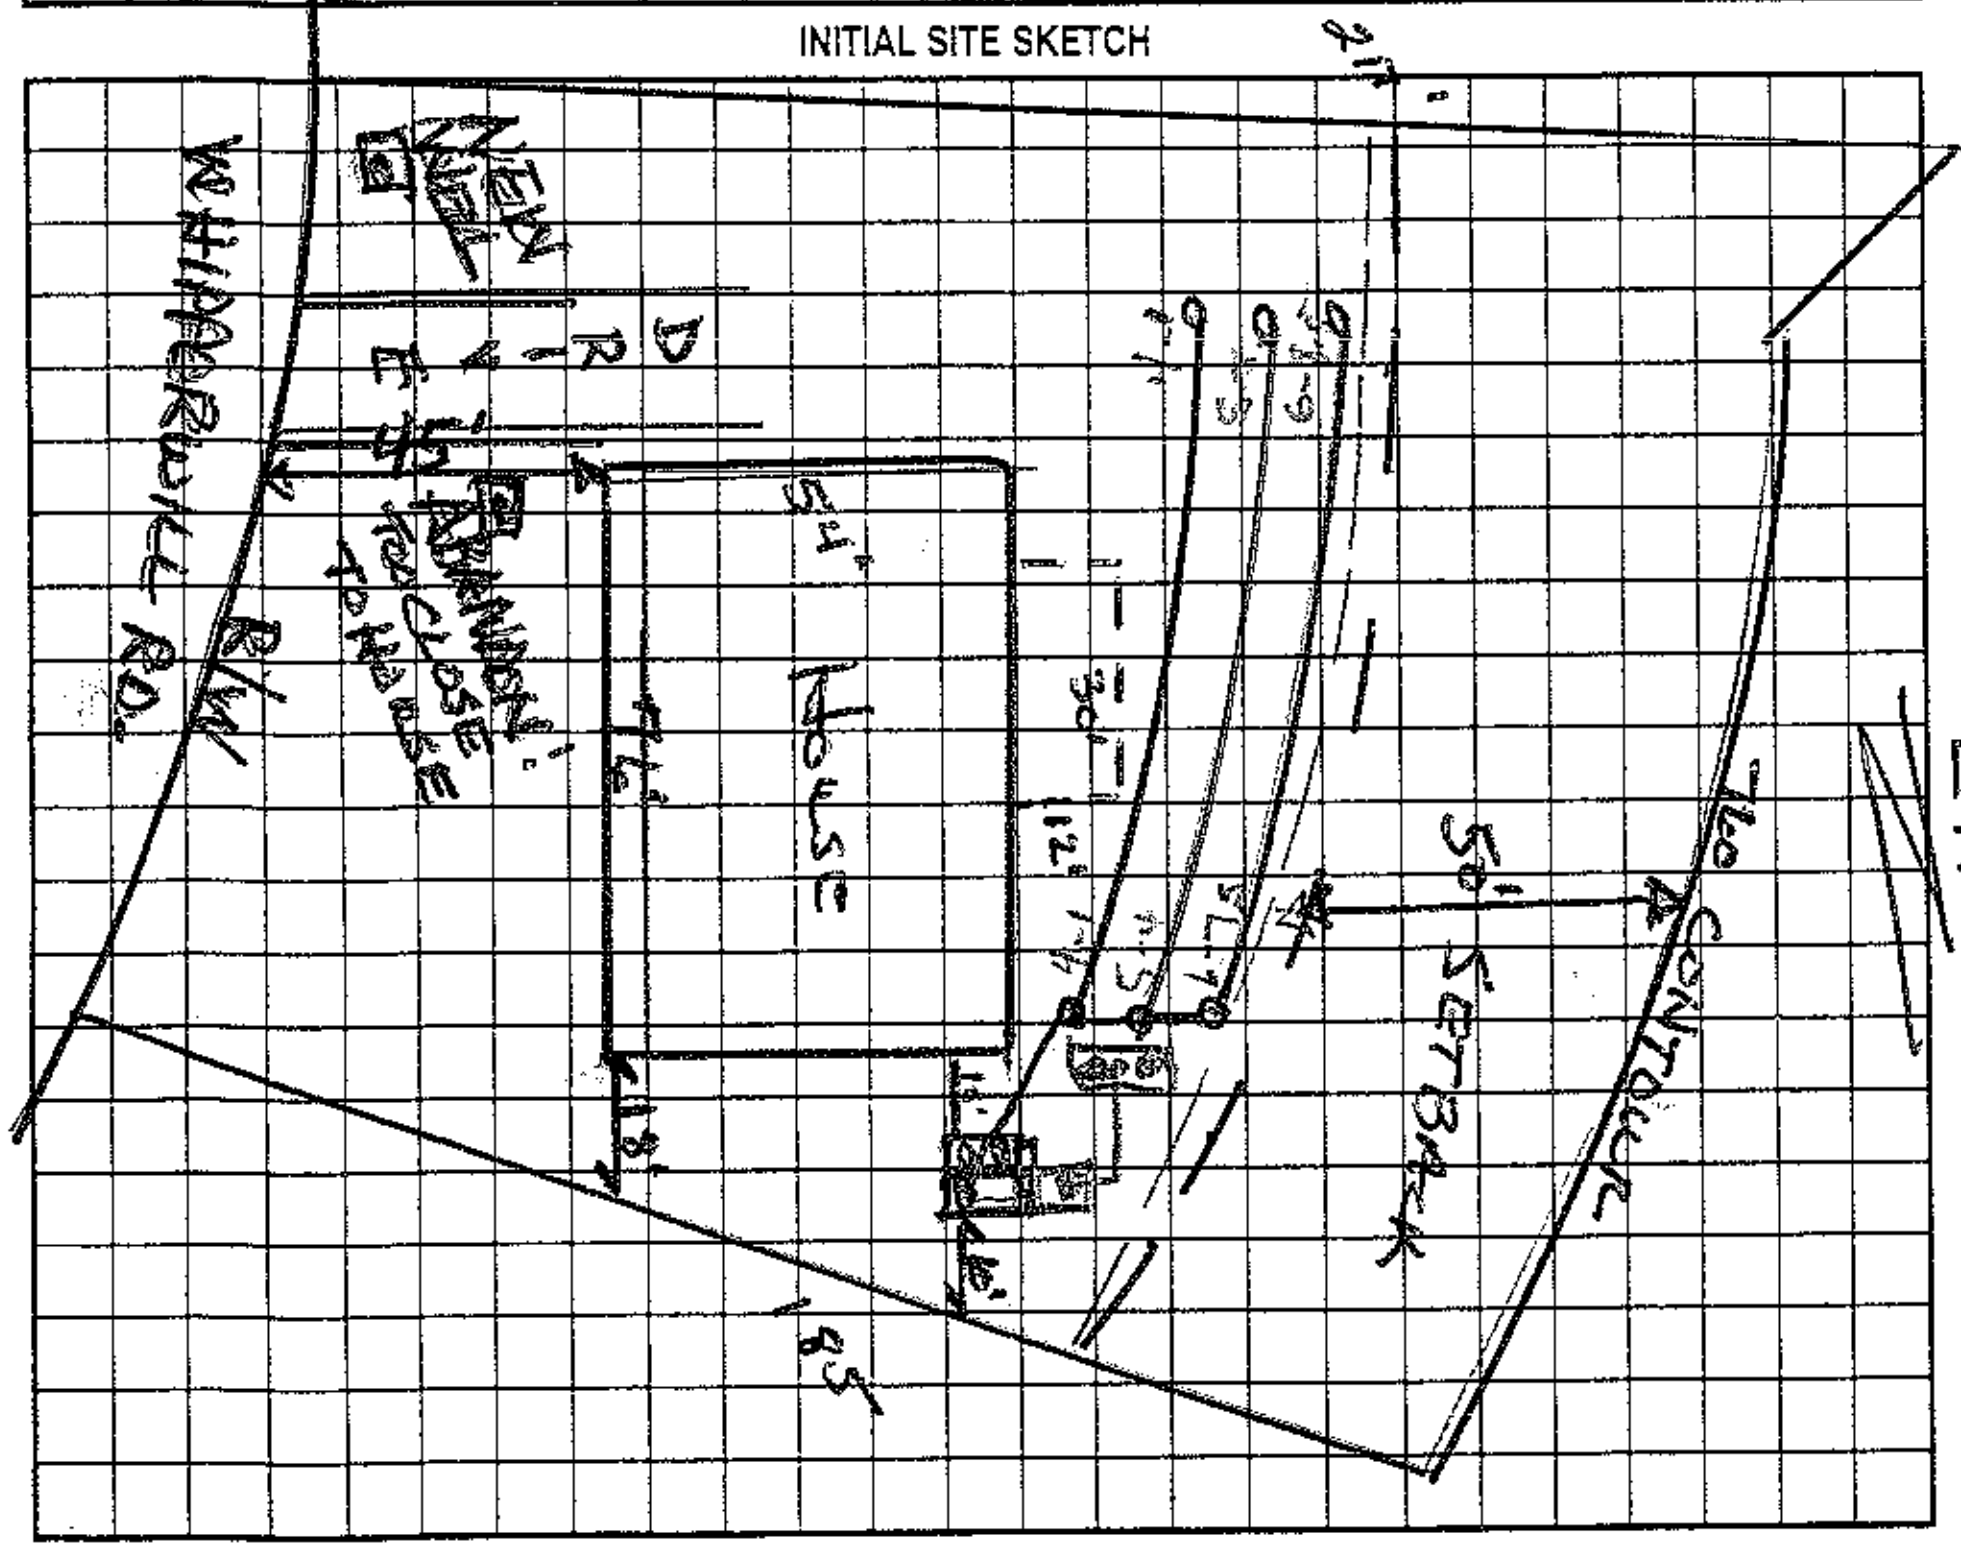

AS BUILT SKETCH

60 Panels - 3/16" holes - Pressure Set

Permit can be suspended or revoked if any false information is supplied toward securing the permit/any unauthorized changes are made to the site/any unauthorized changes are made in the installation of the system. Improvement Permit with plat valid without expiration. Improvement Permit with site plan valid for sixty months. Authorization to Construct is valid for a period equal to that of Improvement Permit – not to exceed sixty months.

Signed: [signature] date 7-15-05 Installed by: LARRY BEAM

Improvement Permit by: Wesley Sparks RS date 7/14/05 Operation Permit by: Wesley Sparks RS date 10/21/08

Authorization to Construct by: Wesley Sparks RS date 7/14/05 Existing System Inspection by: date

HEALTH DEPT. COPY: WHITE OWNER COPY (FINAL): YELLOW OWNER COPY (INITIAL): PINK