IREDELL COUNTY HEALTH DEPARTMENT

STATESVILLE 704-878-5305 MOORESVILLE 704-664-5281

IMPROVEMENT PERMIT / AUTHORIZATION TO CONSTRUCT / OPERATION PERMIT / EXISTING SYSTEM INSPECTION

PERMIT# 130117 PIN# 4637 35 2039 DATE

OWNER OR CONTRACTOR Vasile Lazar PHONE: Business 704 906-5102 Home 704 799 0641

ADDRESS 111 Mandarin Dr. Mooresville NC 28117

LOCATION 150 W. TL Dodie, TR Whippoorwill, on Lt

SUBDIVISION Clot BLOCK / SECTION 10 LOT 35 LOT AREA 0.754c SITE CLASS. 05 DESIGN FLOW 450 L.T.A.R. 0.5

Septic Tank: 1000 Gallons; STB 806/mul Date 2/5/05

Pump Tank: Gallons; PT Date

Pump Make: Model Serial No.

Nitrification Field: No Fields 1 Square Feet ~~1000~~ Linear Feet ~~400~~ 227

No Lines ~~5~~ 3 Trench Width 36" Max Trench Bottom Depth 36" Gravel Depth —

☒ New System ☐ Repair System Type: I, (II), III, IV, V, VI

System Description: Gravity 25% reduction

Repair System Description: Limited, 1945(c)

Maintenance Agreement Required: ☐ Yes ☒ No

☒ House/Mod. Home No. Bedrooms 4

☐ Mobile Home No. Bathrooms

☐ Business No. Employees

☐ Other

☐ Slab ☒ Crawl Space ☒ Basement w/plumbing ☐ Basement wo/plumbing

Water Supply: ☒ Individual ☐ Public ☐ Community


Comments:/Conditions: Sidewall of New Trenches must be 6' from Sidewall of old Bed

1"=50'


Comments:/Conditions: Partial

Using Existing Bed - Added 227' Quick 4

INITIAL SITE SKETCH

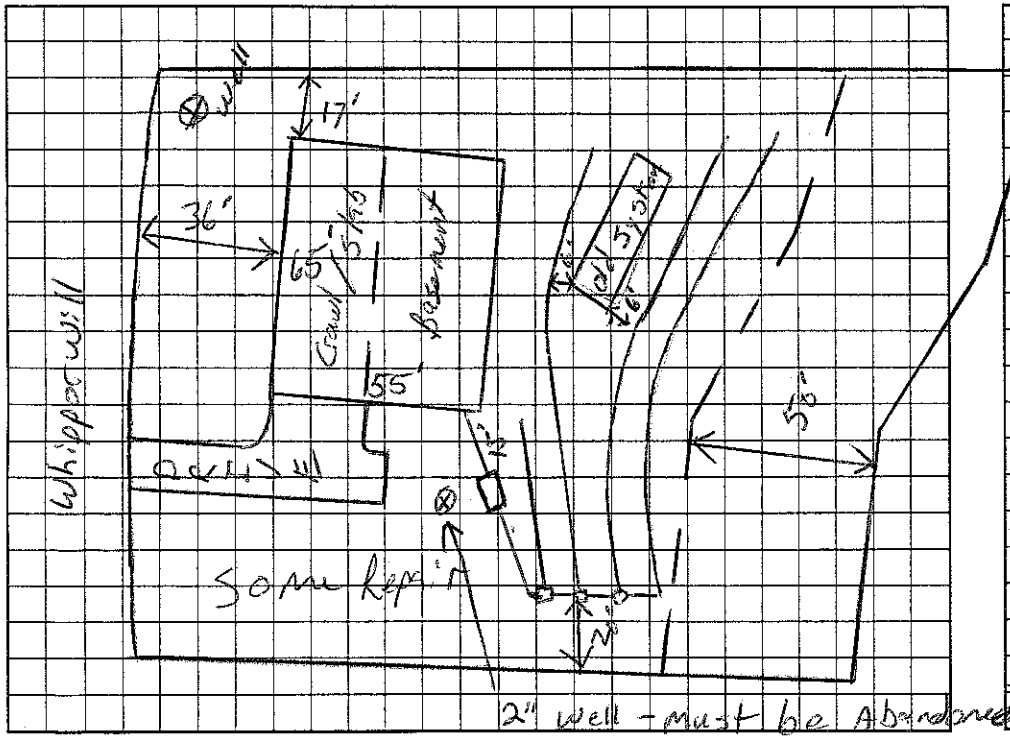

AS BUILT SKETCH

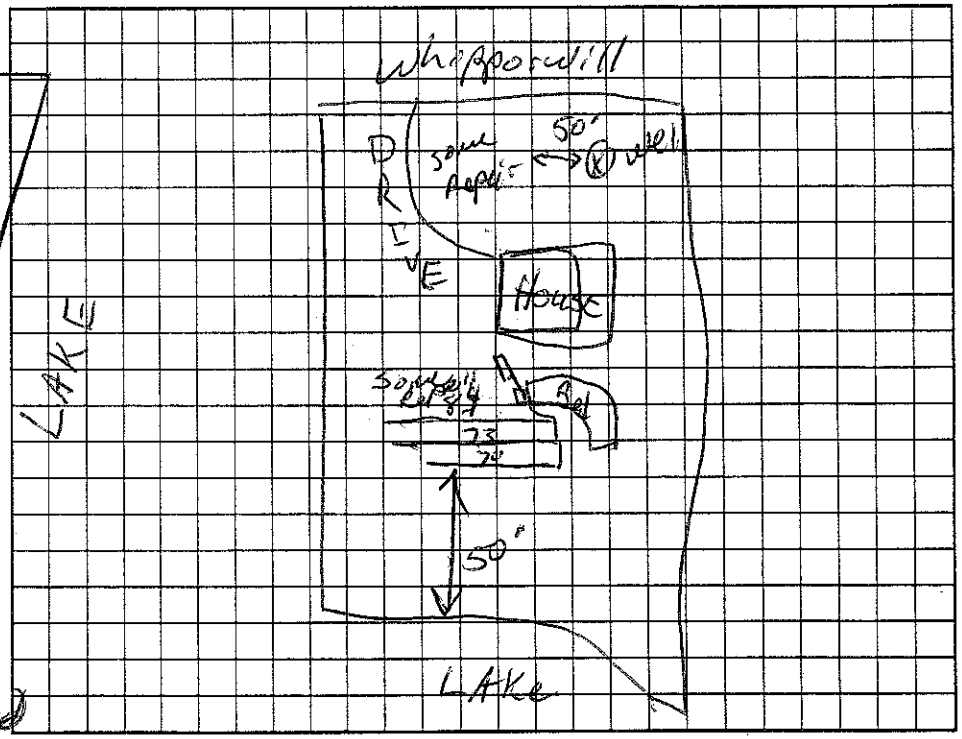

Permit can be suspended or revoked if any false information is supplied toward securing the permit/any unauthorized changes are made to the site/any unauthorized changes are made in the installation of the system. Improvement Permit with plat valid without expiration. Improvement Permit with site plan valid for sixty months. Authorization to Construct is valid for a period equal to that of Improvement Permit – not to exceed sixty months.

Signed: Vasile Lazar date 8/10/05 Installed by: Ray's Septic

Improvement Permit by: RS date 8/10/05 Operation Permit by: RS date 3/3/06

Authorization to Construct by: RS date 8/10/05 Existing System Inspection by: date

HEALTH DEPT. COPY: WHITE OWNER COPY (FINAL): YELLOW OWNER COPY (INITIAL): PINK