$365

IREDELL COUNTY HEALTH DEPARTMENT - *ENVIRONMENTAL HEALTH* ☐ STATESVILLE OFFICE 704-878-5305 ☒ MOORESVILLE OFFICE 704-664-5281

IMPROVEMENT PERMIT / AUTHORIZATION TO CONSTRUCT / OPERATION PERMIT / EXISTING SYSTEM INSPECTION

PERMIT # 16645 PIN # 4637-35-2204 DATE 6-1-11

OWNER Kenneth Laws APPLICANT: Same PHONE: Home/Cell # 704-425-4927 Business #

SITE ADDRESS 287 Whippoorwill Rd OWNER / APPLICANT ADDRESS 7650 Tuckaseegee Rd Kannapolis

SITE DIRECTIONS 150 W, Doolie, Whippoorwill, on L

SUBDIVISION CL&T BLOCK / SECTION 10 LOT # 36 LOT AREA DESIGN FLOW 360 L.T.A.R. .35

Septic Tank 1000 Gallons: STB 160 Date 4-21-11 ☐ New System ☐ Repair ☒ Expansion System Type I II (III) IV V VI ☒ Residence No. Bedrooms 3 **Water Supply** ☒ Private

Pump Tank Gallons: P T Date System Description: 25% Reduction ☐ Business No. Persons ☐ Public

Pump Make Model Serial # Repair System Description: Same (Pump) ☐ Other No. Employees ☐ Community


No. Nitrification Fields: 1 No. Lines 2 Linear Feet 88' Maintenance Agreement Required ☐ YES ☒ NO ☐ Slab ☒ Crawl Space

Trench Width 36" Max. Trench Bottom Depth * 12" * Gravel Depth ☒ GRAVITY ☐ PRESSURE ☐ Basement w/plumbing ☐ Basement w/o plumbing


Comments / Conditions ① 12" Trench Bottom w/ 6" Cover Added To Stay Above Sap. ② Cover Must Be Type I, II Soil

Checked Tank & Drainlines 8-19-11

INITIAL SITE SKETCH

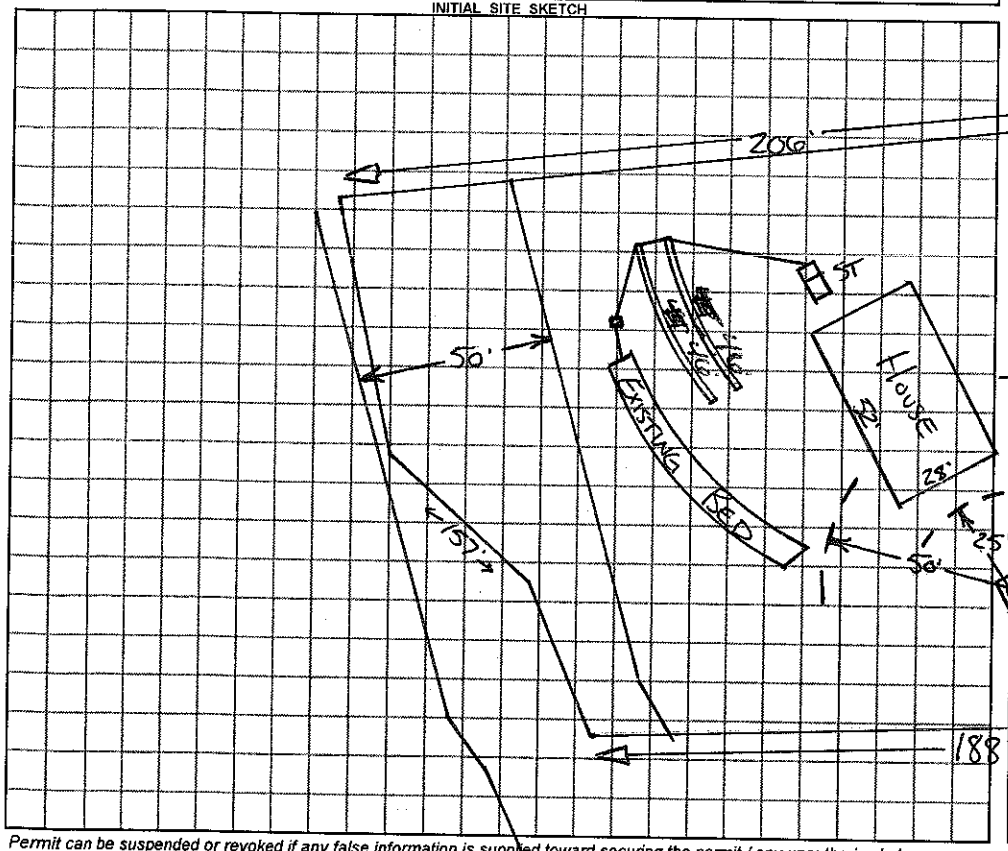

AS BUILT SKETCH

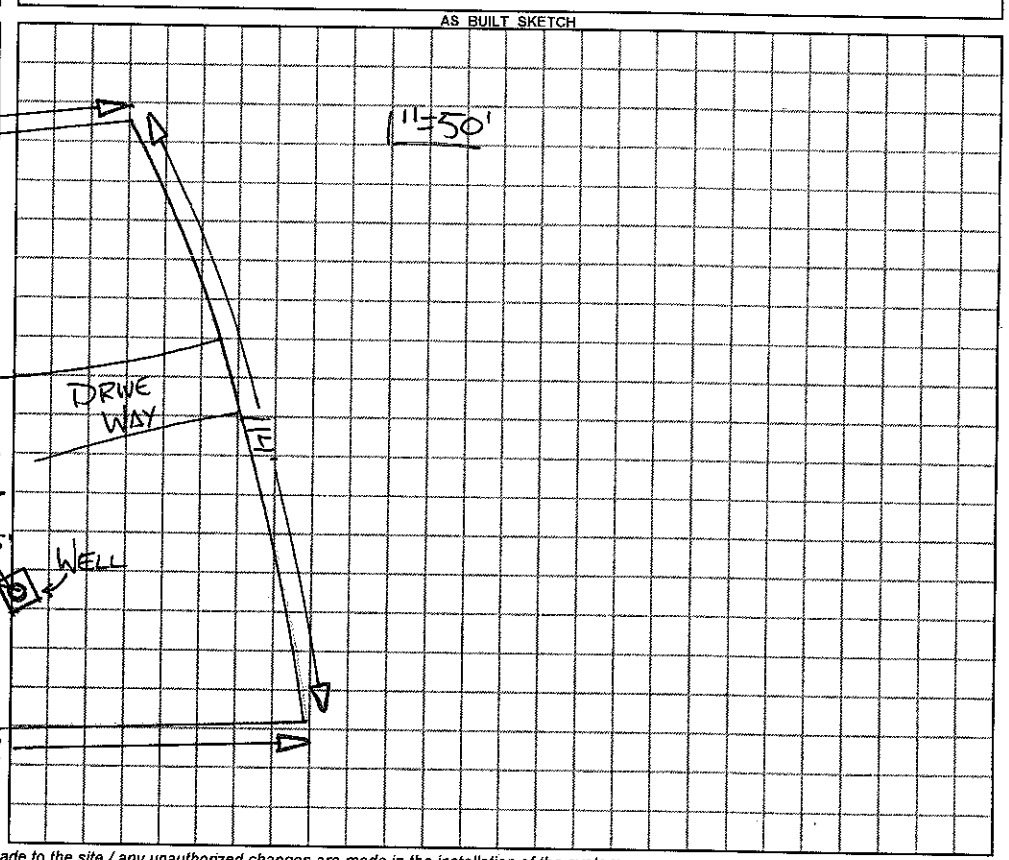

Permit can be suspended or revoked if any false information is supplied toward securing the permit / any unauthorized changes are made to the site / any unauthorized changes are made in the installation of the system.

☐ ***IMPROVEMENT PERMIT*** with plat valid without expiration. ☒ ***IMPROVEMENT PERMIT*** with plat ~~valid without expiration.~~ site plan valid 60 mo. ☒ ***AUTHORIZATION TO CONSTRUCT*** valid for period equal to IMPROVEMENT PERMIT--not to exceed 60 mo.

Owner / Applicant Signature: Kenneth W Laws Date 6/14/11 Installed by: Cothren, Backhoe

IMPROVEMENT PERMIT by: R.A. Wilson REHS Date 6-1-11 OPERATION PERMIT by: R.A. Wilson REHS Date 8-19-11

AUTHORIZATION TO CONSTRUCT by: R.A. Wilson REHS Date 6-14-11 Existing System Inspected by: REHS Date

YOU SHOULD CONTACT A LOCATOR SERVICE PRIOR TO ANY EXCAVATION

White Copy – Environmental Health YELLOW COPY (Final) Owner / Applicant PINK COPY (Initial) Owner / Applicant