2:45 BF

IREDELL COUNTY HEALTH DEPARTMENT

Statesville Office (704) 878-5305 Mooresville Office (704) 660-3625 PERMIT # 20137 7

IMPROVEMENT PERMIT / AUTHORIZATION TO CONSTRUCT / OPERATION PERMIT / EXISTING SYSTEM

PIN # 4637-35-5112

APPLICANT: Jennifer Miller APPLICANT ADDRESS: 159 Creekwood Dr Mooresville NC 28117

SITE ADDRESS: 276 Whippoorwill Rd Mooresville NC PHONE: 704-230-7537 ALT. PHONE:


SITE DIRECTIONS: Hwy 150W, TL on Doolie Rd, TR on Whippoorwill Rd, Lot on R before end

SUBDIVISION: Whippoorwill SECTION: 2 LOT # 44 LOT AREA: 0.913 ac DESIGN FLOW: 480 gpd L.T.A.R.: 0.3


Septic Tank	1000 (gal)	STB 994	Date 9/1/14	☑ New System ☐ Repair ☐ Expansion	System Type: I II (III) IV V VI	☑ Residence	No. Bedrooms 4	Water Supply
Pump Tank	(gal)	PT	Date	System Description: Gravity 25% Reduction		☐ Business	No. Persons 8	☑ Private
Pump Make	Model		Serial #	Repair System Description: LPPBPS		☐ Other	No. Employees	☐ Public
# Nitrification Fields 1	# Lines 4		Linear Ft: 400	Maintenance Agreement Required:	☐ YES ☑ NO	☐ Slab	☑ Crawl Space	☐ Community
Trench Width 36"	Max. Trench Bottom Depth 36"		Gravel Depth N/A	☑ GRAVITY	☐ PRESSURE	☐ Basement w/plumbing	☐ Basement w/o plumbing	

Comments / Conditions:

INITIAL SITE SKETCH

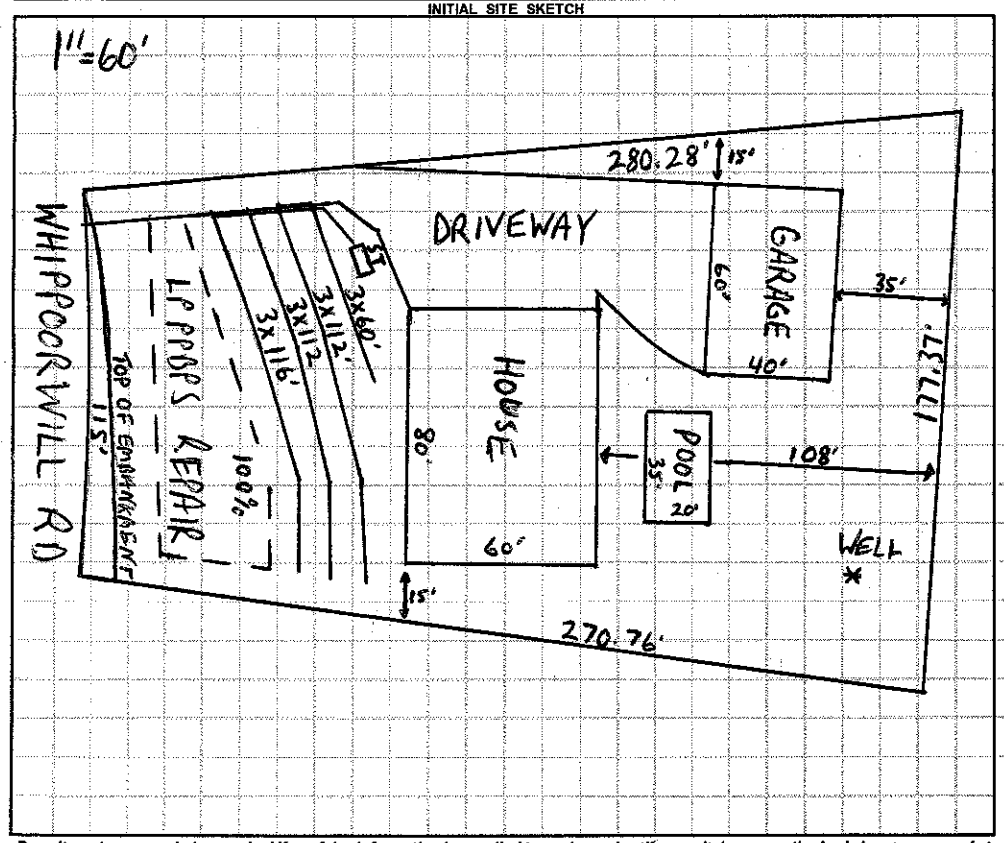

AS BUILT SKETCH

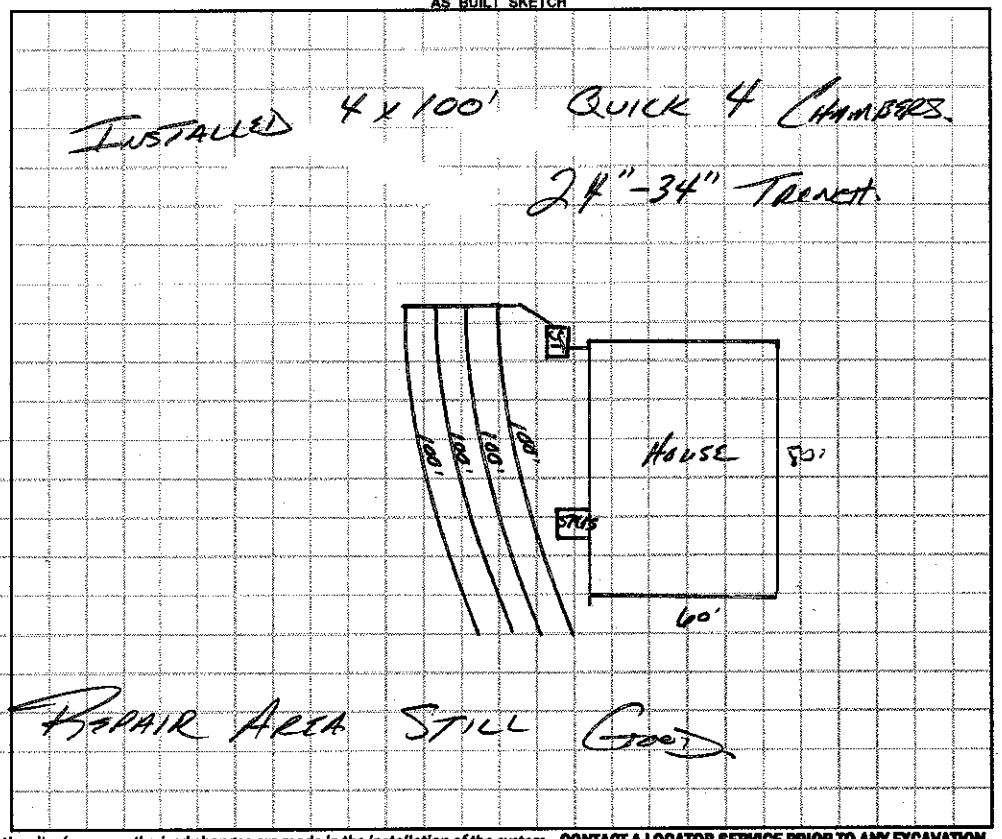

Permit can be suspended or revoked if any false information is supplied toward securing the permit / any unauthorized changes are made to the site / any unauthorized changes are made in the installation of the system. **CONTACT A LOCATOR SERVICE PRIOR TO ANY EXCAVATION**

☐ **IMPROVEMENT PERMIT** *with plat valid without expiration* ☑ **IMPROVEMENT PERMIT** *with site plan valid for 60 mos.* ☑ **AUTHORIZATION TO CONSTRUCT** *valid for period equal to IMPROVEMENT PERMIT--not to exceed 60 mo.*

Owner / Applicant Signature: Date: 3-21-14 Installed by: KEN DELLINGER

IMPROVEMENT PERMIT by: Date: 3-7-14 OPERATION PERMIT by: Date: APPROVED OCT 06 2014

AUTHORIZATION TO CONSTRUCT by: APPROVED JUN 10 2014 Existing System Inspected by: Date:

Health Dept. Copy - WHITE Applicant (Final Approval) - YELLOW Applicant (Conditional Approval) - PINK