IREDELL COUNTY HEALTH DEPARTMENT

STATESVILLE 704-878-5305 MOORESVILLE 704-664-5281

IMPROVEMENT PERMIT / CERTIFICATE OF COMPLETION / OPERATION PERMIT / EXISTING SYSTEM INSPECTION

PROPERTY DESCRIPTION NO. 21038 DATE May 9, 195 TAX MAP NO. 2814A51 4637 35 5971 Watershed: ☑ Yes ☐ No

OWNER OR CONTRACTOR David & Christine Schuck PHONE: Business _____ Home _____ WSIV

ADDRESS 422 E. Center Ave, Mooresville

LOCATION 150 IN TL Doolie Rd. TR Whippoorwill Rd. on Right near end

SUBDIVISION Whippoorwill Woods BLOCK / SECTION _____ LOT 51 LOT AREA .846ac SITE CLASS. B per 1996 DESIGN FLOW 240gpd L.T.A.R. .03

Septic Tank: 1000 Gallons; STB 794 Date 4/1/96

Pump Tank: _____ Gallons; PT _____ Date _____

Pump Make: _____ Model _____ Serial No. _____

Nitrification Field: No Fields 1 Square Feet 600 Linear Feet 200

No Lines 3 Trench Width 36" Max Trench Bottom Depth 36" Gravel Depth NA

☑ New System ☐ Repair System Type: I, II, (III) IV, V, VI

System Description: gravity Infiltrator

Repair System Description: Same

Maintenance Agreement Required: ☐ Yes ☑ No

☑ House/Mod. Home No. Bedrooms 2

☐ Mobile Home No. Bathrooms 2

☐ Business No. Employees _____

☐ Other _____


☐ Slab ☑ Crawl Space ☐ Basement w/plumbing ☐ Basement wo/plumbing

Water Supply: ☑ Individual ☐ Community ☐ Public


Comments:

Comments:

INITIAL SITE SKETCH 1"=50'

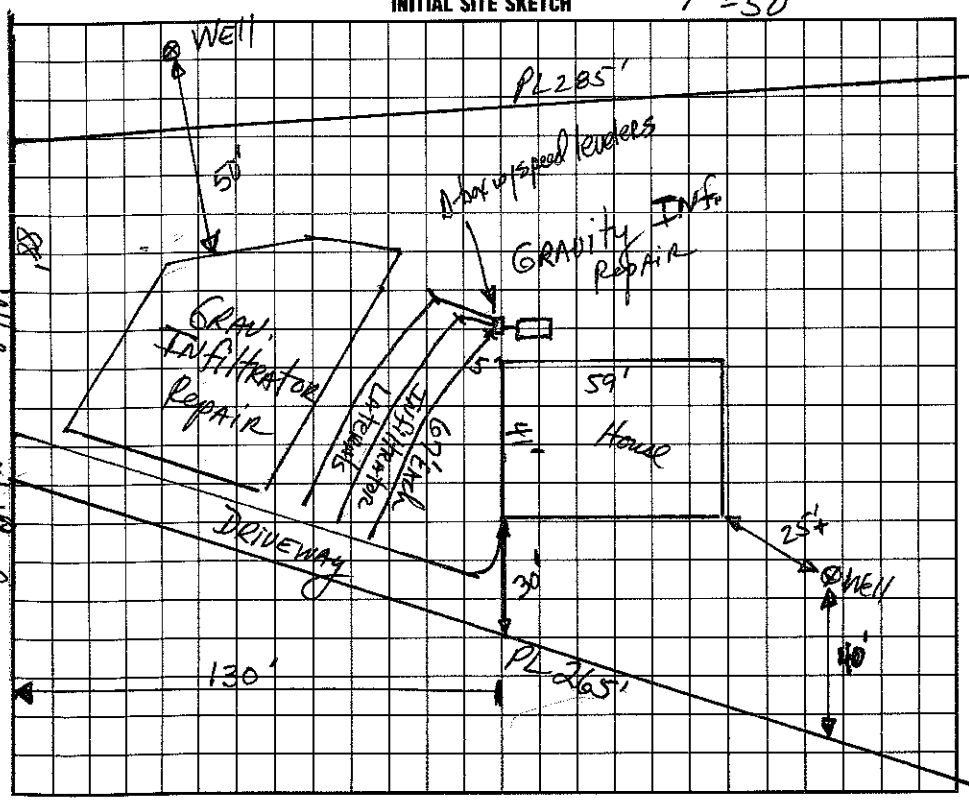

AS BUILT SKETCH

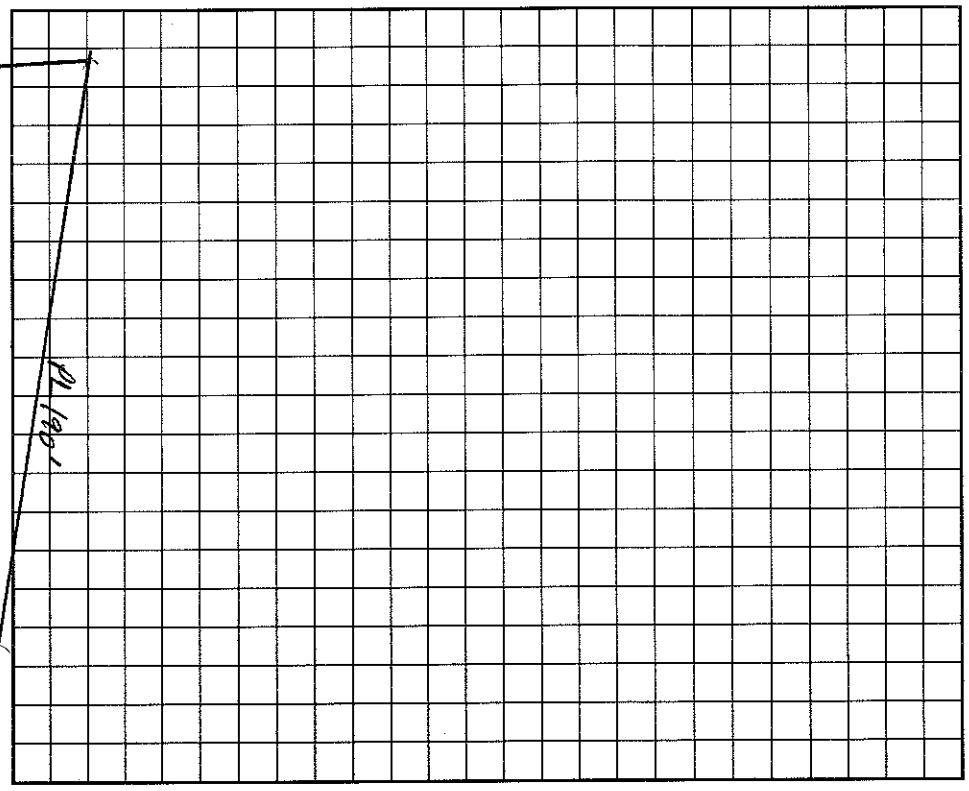

I understand that this permit can be suspended or revoked if any false information is supplied toward securing the permit/any unauthorized changes are made to the site/any unauthorized changes are made in the installation of the system. Improvement Permit is valid for 60 months from date of issuance.

Signed: David & Christine Schuck

Improvement Permit by: Jerrell Hyman, RS date 5/9/95

Existing System Inspection by: _____ date _____

Installed by: F J Ennis

Certificate of Completion by: _____ date _____

Operation Permit by: Wesley Sparks RS. date 6/4/96

HEALTH DEPT. COPY: WHITE INSPECTION COPY (FINAL): GREEN OWNER COPY (FINAL): YELLOW INSPECTION COPY (INITIAL): PINK OWNER COPY (INITIAL): GOLD