IREDELL COUNTY HEALTH DEPARTMENT

STATESVILLE 704-878-5305 MOORESVILLE 704-664-5281

IMPROVEMENT PERMIT / CERTIFICATE OF COMPLETION / OPERATION PERMIT / EXISTING SYSTEM INSPECTION

PROPERTY DESCRIPTION NO. 17537 DATE Dec 13, '93 TAX MAP NO. 2P14A 26 4637835 0667 2 Watershed: ☑ Yes ☐ No

OWNER OR CONTRACTOR Joel Herberg PHONE: Business _____ Home 875-1456 L.N

ADDRESS 15101 Beatties Ford Rd. Huntersville

LOCATION 150 W. on Poplar Rd. TR Whitehall Rd. TR Kingsbury Dr. TR Woodthrush on Rt. in Cul-D-Sac

SUBDIVISION Whitehall Woods BLOCK / SECTION _____ LOT 26 LOT AREA .8913 SITE CLASS. PS DESIGN FLOW 360gpd L.T.A.R. .4 to 36"

Septic Tank: 1000 Gallons; STB 478 Date 6/95

Pump Tank: _____ Gallons; PT _____ Date _____

Pump Make: _____ Model _____ Serial No. _____

Nitrification Field: No Fields 1 Square Feet 900+ Linear Feet 300+

No Lines 2 Trench Width 36" Max Trench Bottom Depth 24"

☑ New System ☐ Repair System Type: I, II, III, IV, V, VI

System Description: Gravity Conventional

Repair System Description: Same

Maintenance Agreement Required: ☐ Yes ☑ No

Gravel Depth 12"

☑ Slab ☐ Crawl Space ☐ Basement w/plumbing ☐ Basement w/o plumbing

☑ House/Mod. Home No. Bedrooms 3

☐ Mobile Home No. Bathrooms 2½

☐ Business No. Employees _____


☐ Other _____

Water Supply: ☑ Individual ☐ Community ☐ Public

Comments: Follow contour with laterals. Maintain specified trench bottom depth.

Comments: 3140 Side Line 98 to back R

INITIAL SITE SKETCH

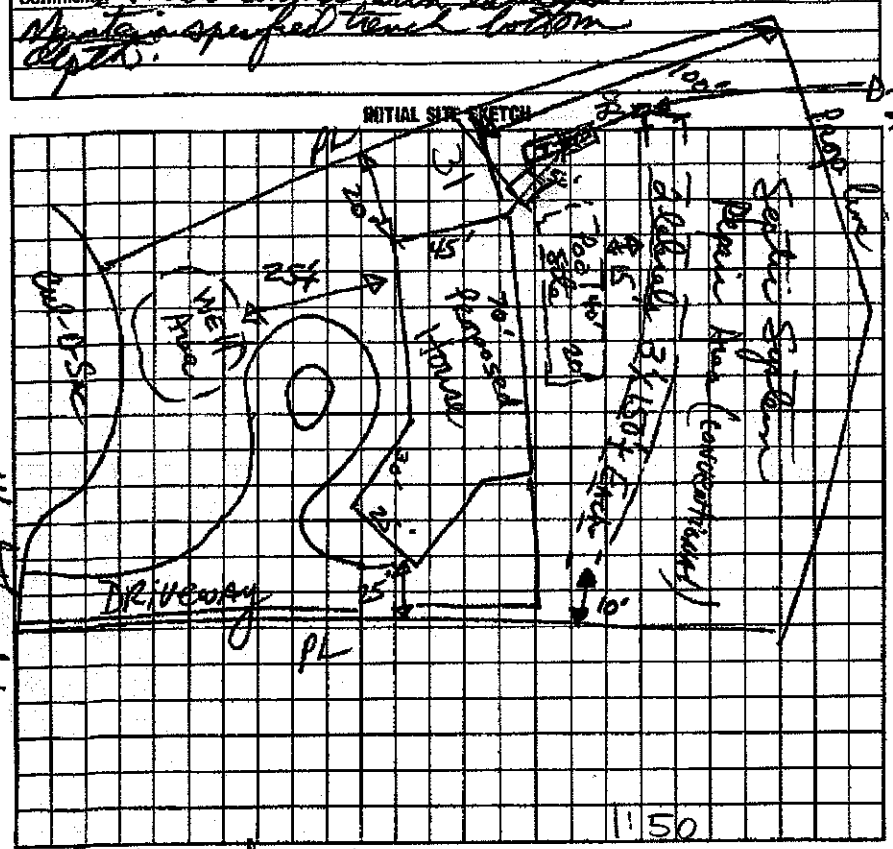

AS BUILT SKETCH

I understand that this permit can be suspended or revoked if any false information is supplied toward securing the permit/any unauthorized changes are made to the site/any unauthorized changes are made in the installation of the system. Improvement Permit is valid for 60 months from date of issuance.

Signed: _____

Improvement Permit by: _____ date 12/13/93

Existing System Inspection by: _____ date _____

Installed by: Kennedy Grading

Certificate of Completion by: Wesley Sparks RS. date 7/26/95

Operation Permit by: _____ date _____

HEALTH DEPT. COPY: WHITE INSPECTION COPY (FINAL): GREEN OWNER COPY (FINAL): YELLOW INSPECTION COPY (INITIAL): PINK OWNER COPY (INITIAL): GOLD