IREDELL COUNTY HEALTH DEPARTMENT

STATESVILLE 704-878-5305 MOORESVILLE 704-664-5281

IMPROVEMENT PERMIT / CERTIFICATE OF COMPLETION / OPERATION PERMIT / EXISTING SYSTEM INSPECTION

PROPERTY DESCRIPTION NO. 20256 DATE Feb 15, 95 TAX MAP NO. 2814A25 4637357765 Watershed: ☑ Yes ☐ No WS IV

OWNER OR CONTRACTOR Jon Grigorian / Genesis Dev. Ltd. PHONE: Business _____ Home _____

ADDRESS 386 Williamson Rd. Mooresville

LOCATION 150 W TL Doolie Rd. TR Whippoorwill Rd. TR Kingfisher TL Woodthrush on Right

SUBDIVISION Whippoorwill Woods BLOCK / SECTION 1 LOT 25 LOT AREA 1.04ac SITE CLASS. PS DESIGN FLOW 360gpd L.T.A.R. .35

Septic Tank: 1000 Gallons; STB 786 Stroy Date 7/14/95

Pump Tank: _____ Gallons; PT _____ Date _____

Pump Make: _____ Model _____ Serial No. _____

Nitrification Field: No Fields 1 Square Feet 1035 Linear Feet 345

No Lines 3 Trench Width 36" Max Trench Bottom Depth 30" Gravel Depth 12"

☑ New System ☐ Repair System Type: I, II, III, IV, V, VI

System Description: gravity conventional

Repair System Description: same

Maintenance Agreement Required: ☐ Yes ☑ No

☑ House/Mod. Home No. Bedrooms 3

☐ Mobile Home No. Bathrooms 2

☐ Business No. Employees ____

☐ Other _____


☐ Slab ☑ Crawl Space ☐ Basement w/plumbing ☐ Basement wo/plumbing

Water Supply: ☑ Individual ☐ Community ☐ Public


Comments:

Comments: installed substantially as shown

INITIAL SITE SKETCH

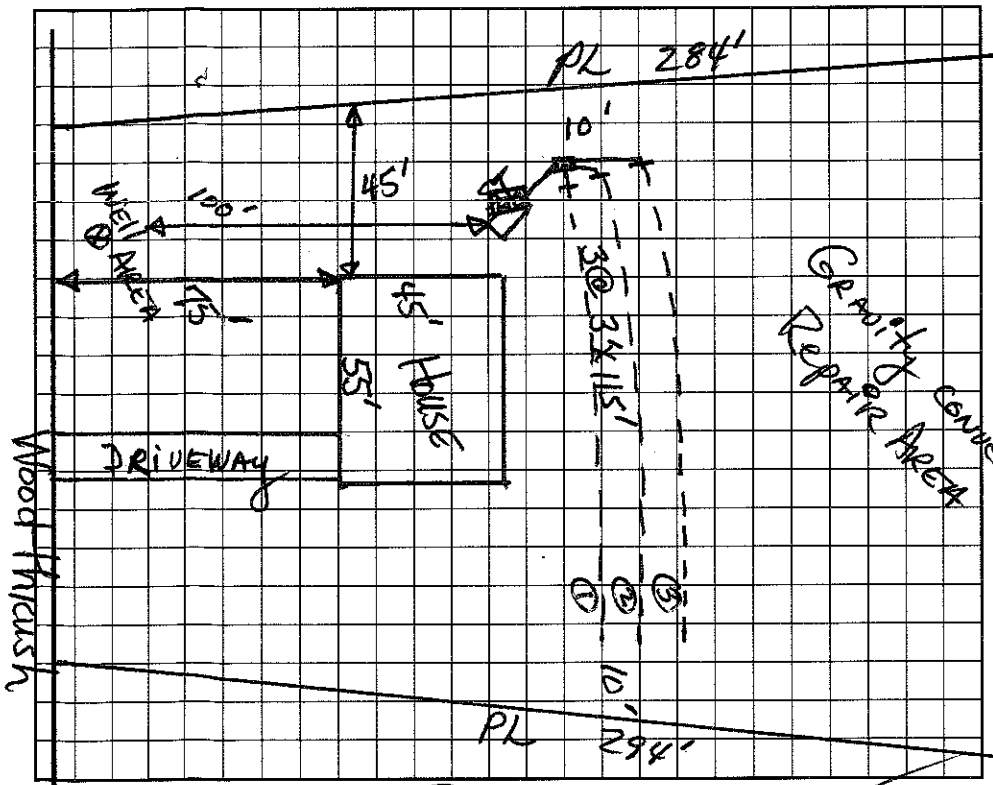

AS BUILT SKETCH

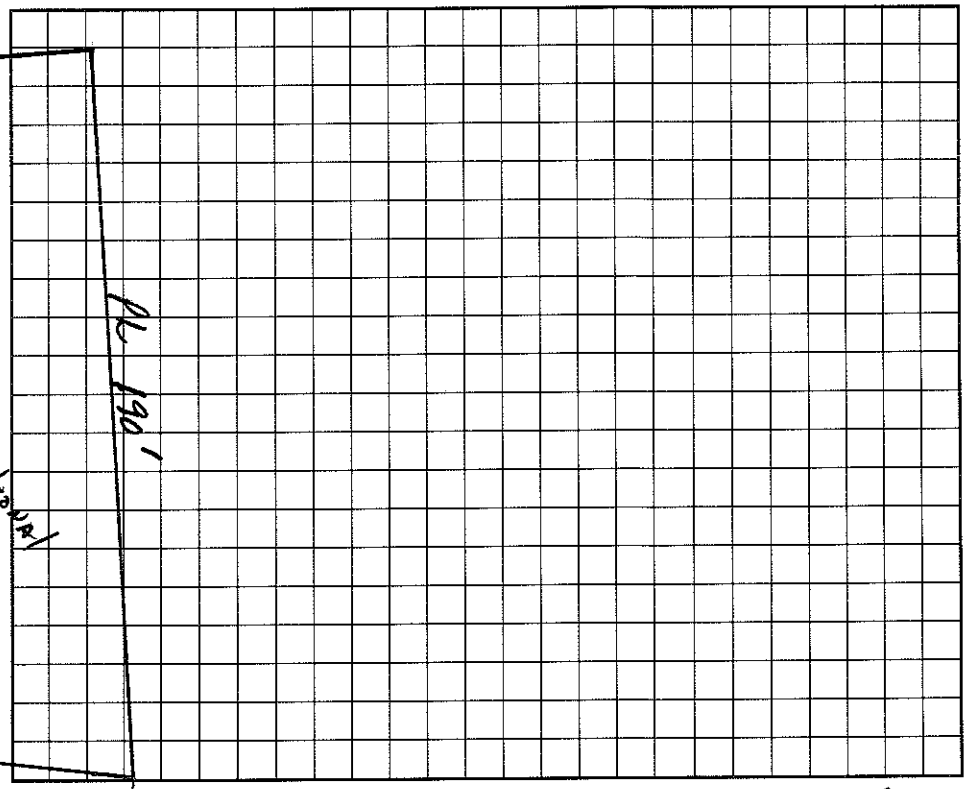

I understand that this permit can be suspended or revoked if any false information is supplied toward securing the permit/any unauthorized changes are made to the site/any unauthorized changes are made in the installation of the system. Improvement Permit is valid for 60 months from date of issuance.

Signed _____

Improvement Permit by: _____ date Feb 15, 95

Existing System Inspection by: _____ date _____

Installed by: Fingers Landscaping 2725 Sharlott St Belmont

Certificate of Completion by: _____ date _____

Operation Permit by: _____ date 10/11/95

HEALTH DEPT. COPY: WHITE INSPECTION COPY (FINAL): GREEN OWNER COPY (FINAL): YELLOW INSPECTION COPY (INITIAL): PINK OWNER COPY (INITIAL): GOLD