IREDELL COUNTY HEALTH DEPARTMENT

Statesville Office (704) 878-5305 Mooresville Office (704) 660-3625 PERMIT # 207783

IMPROVEMENT PERMIT / AUTHORIZATION TO CONSTRUCT / OPERATION PERMIT / EXISTING SYSTEM

PIN # 4637-35-7765.000

APPLICANT: Brian Galluzzi APPLICANT ADDRESS: P.O. Box 4416 Mooresville NC 28117

SITE ADDRESS: 120 Wood Thrush Ln. Mooresville NC 28117 PHONE: 704-662-2662 ALT. PHONE: 704-200-6728

SITE DIRECTIONS: Hwy 150 W, TL Doolie Rd., TR Whippoorwill Rd., TR King Fisher, TL Wood Thrush, Site on R.

SUBDIVISION: Whippoorwill Woods SECTION: M1 LOT # 25 LOT AREA: 1.07 Acre DESIGN FLOW: 360 GPD L.T.A.R.: Existing .35

Septic Tank Existing 1000 (gal) STB Date

Pump Tank (gal) PT Date

Pump Make Model Serial #

Nitrification Fields Existing # Lines 3@115' Ex. Linear Ft: 345' Ex.

Trench Width 36" Ex. Max. Trench Bottom Depth 30" Ex. Gravel Depth 12" Existing.

☐ New System ☐ Repair ☐ Expansion System Type: I (II) III IV V VI

System Description: Existing Conventional

Repair System Description: Conventional

Maintenance Agreement Required: ☐ YES ☒ NO

☑ GRAVITY ☐ PRESSURE

☒ Residence No. Bedrooms 3

☐ Business No. Persons 6

☐ Other No. Employees


☐ Slab ☒ Crawl Space

☐ Basement w/plumbing ☐ Basement w/o plumbing


Water Supply: ☒ Private ☐ Public ☐ Community

Comments / Conditions: System Appeared To Be Functioning At Time Of Inspection.

INITIAL SITE SKETCH

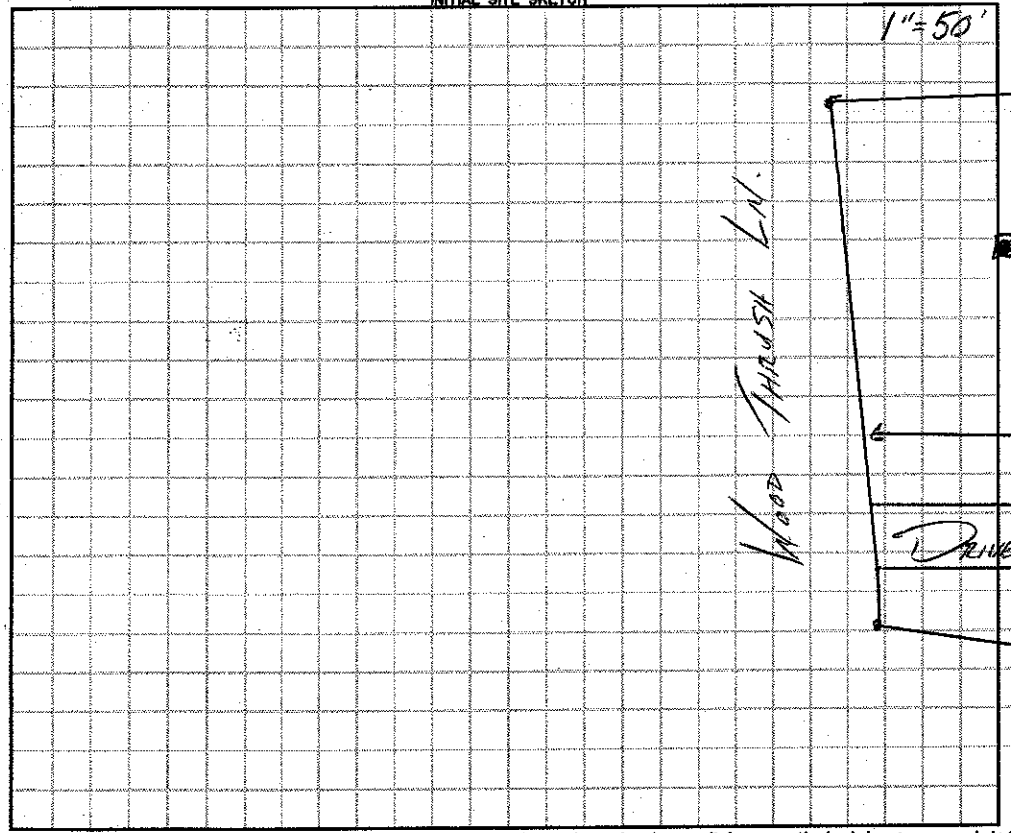

AS BUILT SKETCH

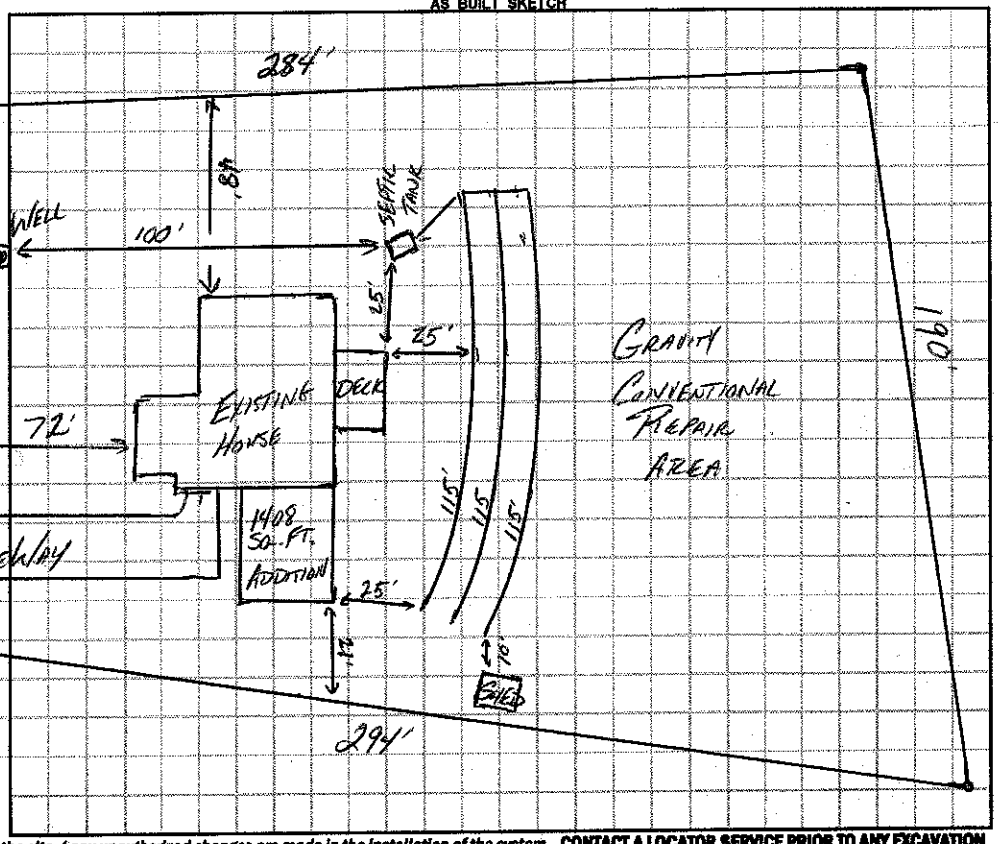

Permit can be suspended or revoked if any false information is supplied toward securing the permit / any unauthorized changes are made to the site / any unauthorized changes are made in the installation of the system. **CONTACT A LOCATOR SERVICE PRIOR TO ANY EXCAVATION**

☐ **IMPROVEMENT PERMIT** *with plat valid without expiration.* ☐ **IMPROVEMENT PERMIT** *with site plan valid for 60 mos.* ☐ **AUTHORIZATION TO CONSTRUCT** *valid for period equal to IMPROVEMENT PERMIT--not to exceed 60 mo.*

Owner / Applicant Signature: Date: 1-23-15 Installed by:

IMPROVEMENT PERMIT by: Date: OPERATION PERMIT by: Date:

AUTHORIZATION TO CONSTRUCT by: Date: Existing System Inspected by: Date: APPROVED JAN 23 2015

Health Dept. Copy - WHITE Applicant (Final Approval) - YELLOW Applicant (Conditional Approval) - PINK