IREDELL COUNTY HEALTH DEPARTMENT

STATESVILLE 704-878-5305 MOORESVILLE 704-664-5281

IMPROVEMENT PERMIT / CERTIFICATE OF COMPLETION / OPERATION PERMIT / EXISTING SYSTEM INSPECTION

PROPERTY DESCRIPTION NO. 17845 DATE Feb. 24, '94 TAX MAP NO. 2914A24 4637 35 8896 Watershed: ☑ Yes ☐ No

OWNER OR CONTRACTOR Jeff Fowler PHONE: Business _____ Home L.N.

ADDRESS 7306 Wilson Grove Rd, Charlotte

LOCATION 150 W Fr Woolie Rd. TR Whipporwill TR Kingfisher TR Woodthrush 3rd lot on Right

SUBDIVISION Whipporwill BLOCK / SECTION _____ LOT 24 LOT AREA ~ 3/4 Ac SITE CLASS. RS DESIGN FLOW 360gpd L.T.A.R. .3

Septic Tank: 1000 Gallons; STB 794 Date 4-11-94

Pump Tank: _____ Gallons; PT _____ Date _____

Pump Make: _____ Model _____ Serial No. _____

Nitrification Field: No Fields 1 Square Feet 1200 Linear Feet 400

No Lines 4 Trench Width 36" Max Trench Bottom Depth 36" Gravel Depth 12"

☐ New System ☐ Repair System Type: I (II) III, IV, V, VI.

System Description: gravity conventional

Repair System Description: _____

Maintenance Agreement Required: ☐ Yes ☑ No

☐ House/Mod. Home No. Bedrooms 3

☐ Mobile Home No. Bathrooms 2

☐ Business No. Employees _____

☐ Other _____

☐ Slab ☑ Crawl Space ☐ Basement w/plumbing ☐ Basement wo/plumbing


Water Supply: ☑ Individual ☐ Community ☐ Public

Comments: Well installed upon arriving for first site visit.


5/23/94 ST installed as repaired to use deep area, OK.

Comments:

INITIAL SITE SKETCH

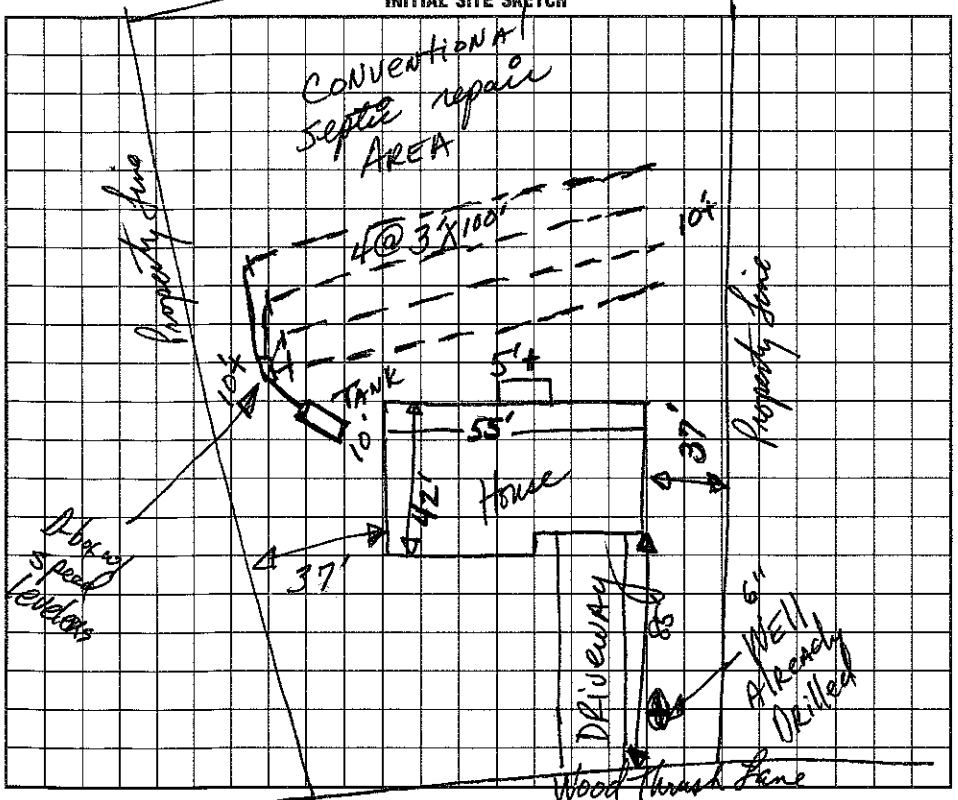

AS BUILT SKETCH

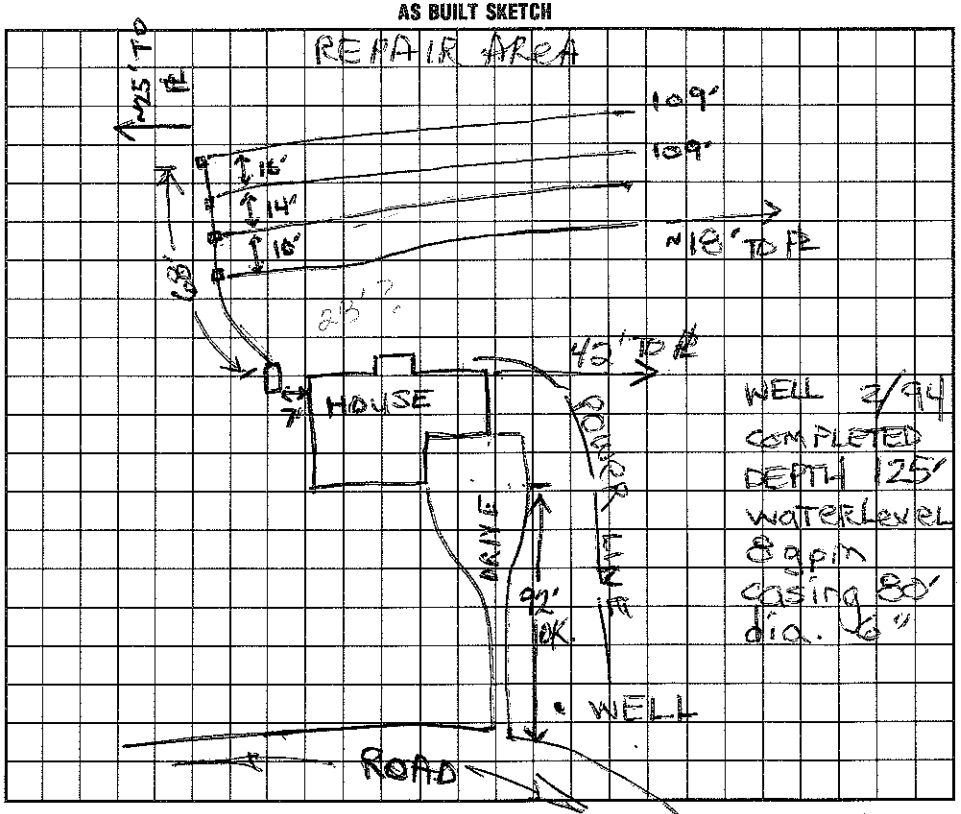

I understand that this permit can be suspended or revoked if any false information is supplied toward securing the permit/any unauthorized changes are made to the site/any unauthorized changes are made in the installation of the system. Improvement Permit is valid for 60 months from date of issuance.

Signed: _____

Improvement Permit by: _____ date 2/24/94

Existing System Inspection by: _____ date _____

Installed by: Walt Burton

Certificate of Completion by: Andrea Lemon date 6-3-94

Operation Permit by: _____ date _____

HEALTH DEPT. COPY: WHITE INSPECTION COPY (FINAL): GREEN OWNER COPY (FINAL): YELLOW INSPECTION COPY (INITIAL): PINK OWNER COPY (INITIAL): GOLD