ICHD - ENVIRONMENTAL HEALTH DIVISION

Statesville Office (704) 878-5305 | Mooresville Office (704) 660-3625 | PERMIT # AP 2023-14839

SEPTIC: IMPROVEMENT PERMIT / AUTHORIZATION TO CONSTRUCT / OPERATION PERMIT / EXISTING SYSTEM

PIN # 4637 -- 36 -- 0509

APPLICANT/OWNER: Jeanie Lentz | APPLICANT ADDRESS: 463 Lentz Rd, Statesville 28625

SITE ADDRESS: 135 Hidden Ln, Mooresville 28117 | PHONE: 980-829-3278 | ALT. PHONE 704-447-1829 (owner)

SITE DIRECTIONS: River Hwy - (L) McCrary - (R) Tara Rd - (R) Hidden Ln - Lot on (L) | SAP CONTROLLED: ☐ YES ☐ NO

SUBDIVISION: Hidden Cove | SECTION: — | LOT # 4 | LOT AREA: Not on GIS | DESIGN FLOW: EX. | L.T.A.R.: EX.

Septic Tank 1000 (gal) STB 7160 Date 1/21/23
Pump Tank (gal) PT Date
Pump Make Model Serial #
Nitrification Fields # Lines Linear Ft
Trench Width Trench Bottom Depth(Low side) Gravel Depth

EXISTING


☐ New System ☑ Repair ☐ Expansion System Type: I (II) III IV V VI
System Description: EX
Repair System Description: EX.
Maintenance Agreement Required: ☐ YES ☐ NO ☐ GRAVITY ☐ PRESSURE

☑ Residence ☐ Business ☐ Other ☐ Slab ☐ Crawl Space ☑ Basement w/plumbing ☐ Basement w/o plumbing
No. Bedrooms 3 | No. Persons 6 | No. Employees

Water Supply: ☑ Private ☐ Public ☐ Community

Comments / Conditions: Pump, crush, fill old tank.
5' from all foundation footers. If 10' from drain cannot be maintained, pipe not meeting setbacks must be hardpipe.

INITIAL SITE SKETCH

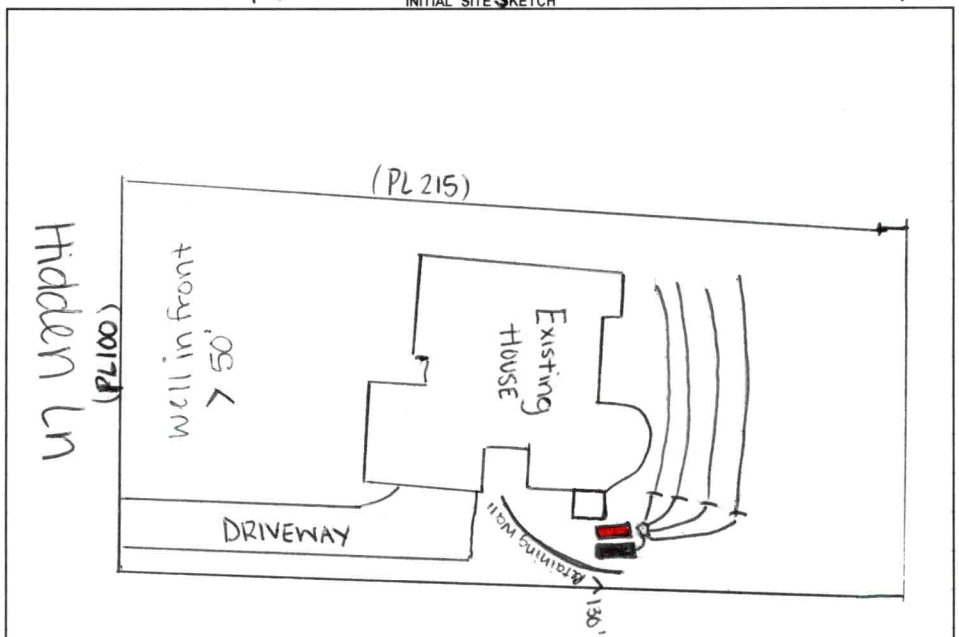


AS BUILT SKETCH

FOR SEPTIC FINAL INSPECTION CALL: 704-664-3703 between 8am-9am
the day the inspection is needed. Be sure to speak with an inspector to confirm your time.

Old S.T. to be replaced
New S.T.
* Keep tank 10' off property line

D-box not set → T-pipe, for equal flow

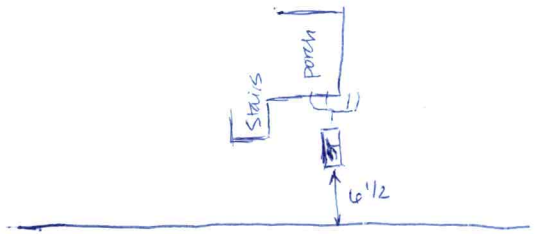

Permit can be suspended or revoked if any false information is supplied toward securing the permit / any unauthorized changes are made to the site / any unauthorized changes are made in the installation of the system. **CONTACT A LOCATOR SERVICE PRIOR TO ANY EXCAVATION**

☐ **IMPROVEMENT PERMIT** ***with plat*** *valid without expiration.* ☑ **IMPROVEMENT PERMIT** ***with site plan*** *valid for 60 mos.* ☑ **AUTHORIZATION TO CONSTRUCT** *valid for period equal to IMPROVEMENT PERMIT--not to exceed 60 mo.*

Owner / Applicant Signature: Online | Date: 1/27/23 | Installed by: Lentz Wastewater

IMPROVEMENT PERMIT by: Sydney Holland | Date: 1/31/23 | OPERATION PERMIT by: D Wieberg | Date: 4/6/23

AUTHORIZATION TO CONSTRUCT by: Sydney Holland | Date: 1/31/23 | Existing System Inspected by: | Date:

FOR SEPTIC FINAL INSPECTION: CALL 704-664-3703 between 8am-9am the day the inspection is needed.