ICHD - ENVIRONMENTAL HEALTH DIVISION

BCW

Statesville Office (704) 878-5305 | Mooresville Office (704) 660-3625

PERMIT # AP 2023-14839

OSWP

SEPTIC: IMPROVEMENT PERMIT / AUTHORIZATION TO CONSTRUCT / OPERATION PERMIT / EXISTING SYSTEM

PIN # 4637 -- 36 -- 0509

APPLICANT/OWNER: Jeanie Lentz

APPLICANT ADDRESS: 463 Lentz Rd, Statesville 28625

SITE ADDRESS: 135 Hidden Ln, Mooresville, 28117

PHONE: 980-829-3278

ALT. PHONE 704-447-1829 (owner)

SITE DIRECTIONS: River Hwy - (L) McCrary - (R) Tara Rd - (R) Hidden Ln - Lot on (L)

SAP CONTROLLED: ☐ YES ☐ NO

SUBDIVISION: Hidden Cove

SECTION: — LOT # 4 LOT AREA: Not on GIS


DESIGN FLOW: EX. L.T.A.R.: EX.

Septic Tank	1000	(gal)	STB	7160	Date	1/21/23	☐ New System	☑ Repair	☐ Expansion	System Type: I II III IV V VI	
Pump Tank		(gal)	PT		Date		System Description:	EX			
Pump Make			Model		Serial #		Repair System Description:	EX.			
# Nitrification Fields	EXISTING		# Lines		Linear Ft		Maintenance Agreement Required:	☐ YES ~~NO~~			
Trench Width			Trench Bottom Depth(Low side)		Gravel Depth			☐ GRAVITY ~~PRESSURE~~			

☑ Residence	No. Bedrooms	3	**Water Supply**
☐ Business	No. Persons	10	☑ Private
☐ Other	No. Employees		☐ Public
☐ Slab	☐ Crawl Space		☐ Community
☑ Basement w/plumbing			☐ Basement w/o plumbing

Comments / Conditions: Pump, crush, fill old tank.
5' from all foundation footers. If 10' from drain cannot be maintained, pipe not meeting setbacks must be hardpipe.

INITIAL SITE SKETCH

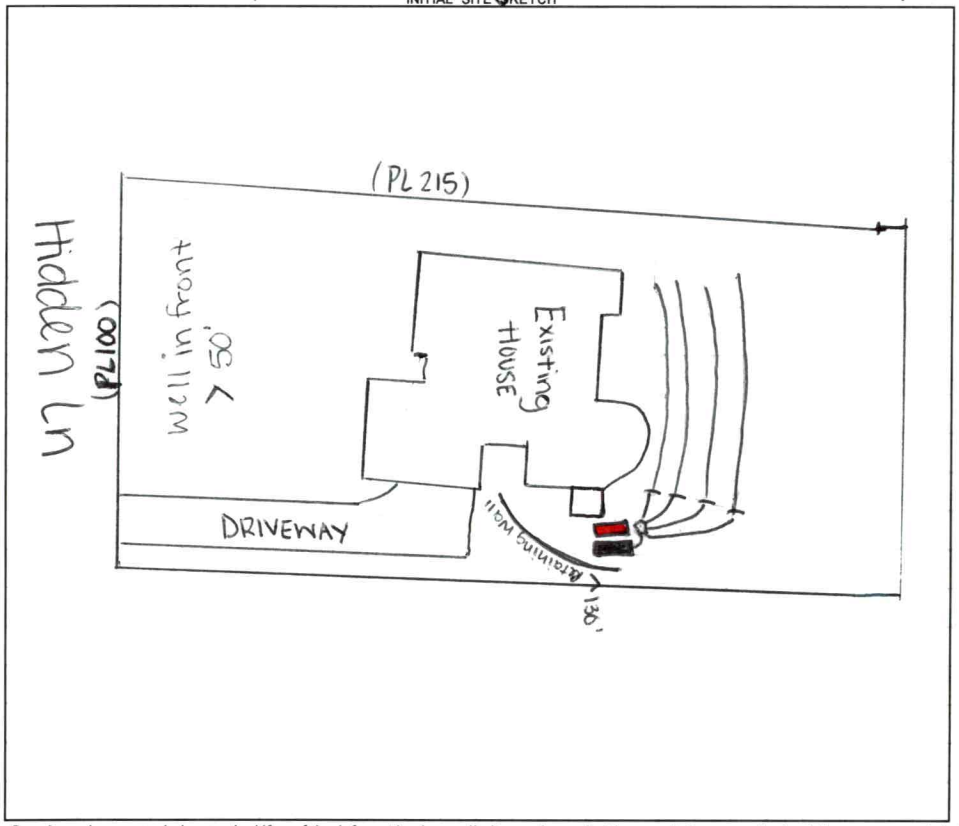

AS BUILT SKETCH


FOR SEPTIC FINAL INSPECTION CALL: 704-664-3703 between 8am-9am
the day the inspection is needed. Be sure to speak with an inspector to confirm your time.

Old S.T. to be replaced

New S.T.

* Keep tank 10' off property line

D-box not set → T-pipe, for equal flow

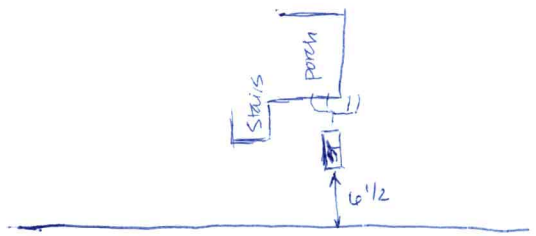

Permit can be suspended or revoked if any false information is supplied toward securing the permit / any unauthorized changes are made to the site / any unauthorized changes are made in the installation of the system. **CONTACT A LOCATOR SERVICE PRIOR TO ANY EXCAVATION**

☐ **IMPROVEMENT PERMIT** ***with plat*** *valid without expiration.* ☑ **IMPROVEMENT PERMIT** ***with site plan*** *valid for 60 mos.* ☑ **AUTHORIZATION TO CONSTRUCT** *valid for period equal to IMPROVEMENT PERMIT--not to exceed 60 mo.*

Owner / Applicant Signature: Online Date: 1/27/23 Installed by: Lentz Wastewater

IMPROVEMENT PERMIT by: Sydney Holland Date: 1/31/23 OPERATION PERMIT by: D Wieberg Date: 4/6/23

AUTHORIZATION TO CONSTRUCT by: Sydney Holland Date: 1/31/23 Existing System Inspected by: Date:

FOR SEPTIC FINAL INSPECTION: CALL 704-664-3703 between 8am-9am the day the inspection is needed.