IREDELL COUNTY HEALTH DEPARTMENT

STATESVILLE 704-878-5305 MOORESVILLE 704-664-5281

IMPROVEMENT PERMIT / AUTHORIZATION TO CONSTRUCT / OPERATION PERMIT / EXISTING SYSTEM INSPECTION

PERMIT# 108174 PIN# 4637-36-0797 DATE 9/19/03

OWNER OR CONTRACTOR David V. Reynolds PHONE: Business 704-201-9651 Home

ADDRESS 127 Hidden Ln, Mooresville NC 28117

LOCATION Hwy 150 W, TL McCrary Rd, TL Tara, TL Hidden Ln

SUBDIVISION Hidden Cove BLOCK / SECTION LOT 6 LOT AREA 0.57AC SITE CLASS PS DESIGN FLOW 360 L.T.A.R. 0.3

Septic Tank: 1000 Gallons; STB 3/2 Date 8/5/03
Pump Tank: 1000 Gallons; PT 27 Date
Pump Make: Myers Model ME50 Serial No.
Nitrification Field: No Fields 1 Square Feet 630 sq. Linear Feet 210'
No Lines 6@35 Trench Width 24" Max Trench Bottom Depth 36" Gravel Depth —

☒ New System ☐ Repair System Type: I, II, III, (IV), V, VI
System Description: LP Panel Block
Repair System Description: Used Prior to 1983
Maintenance Agreement Required: ☒ Yes ☐ No


☒ House/Mod. Home No. Bedrooms 3
☐ Mobile Home No. Bathrooms 2.5
☐ Business No. Employees
☐ Other
☐ Slab ☐ Crawl Space ☒ Basement w/plumbing ☐ Basement wo/plumbing

Water Supply: ☒ Individual ☐ Public ☐ Community


Comments:/Conditions:

Comments:/Conditions:
45 Panels
3/16" holes

INITIAL SITE SKETCH

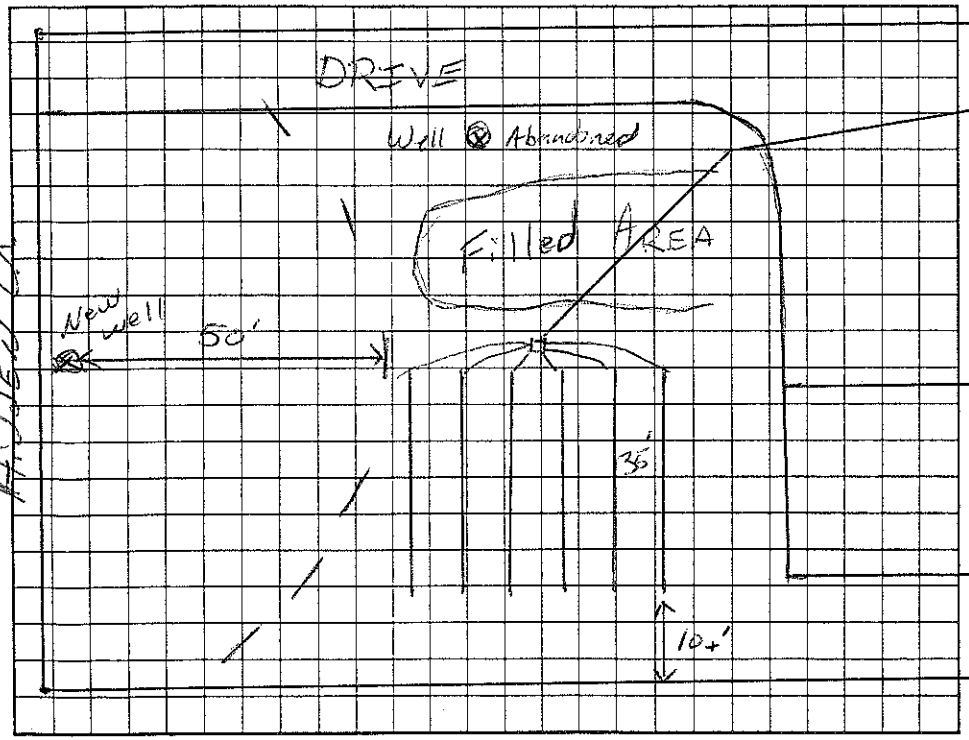

AS BUILT SKETCH

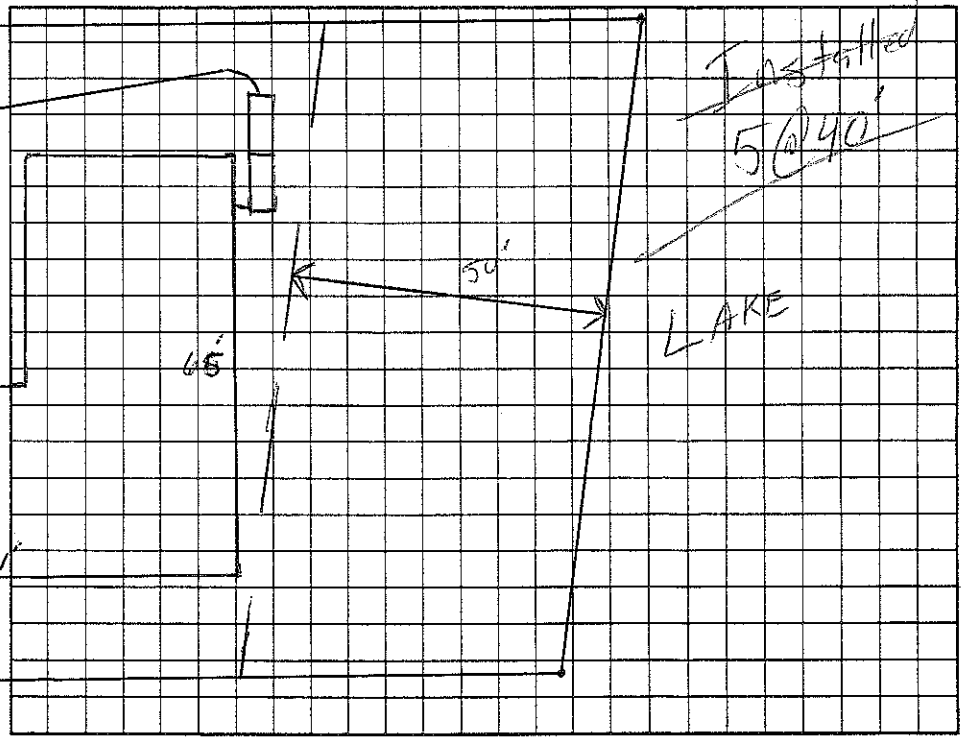

Permit can be suspended or revoked if any false information is supplied toward securing the permit/any unauthorized changes are made to the site/any unauthorized changes are made in the installation of the system. Improvement Permit with plat valid without expiration. Improvement Permit with site plan valid for sixty months. Authorization to Construct is valid for a period equal to that of Improvement Permit – not to exceed sixty months.

Signed: date 9/22/03 Installed by: Stanley Septic

Improvement Permit by: RS date 9/19/03 Operation Permit by: RS date 9/29/03

Authorization to Construct by: date 9/19/03 Existing System Inspection by: date

HEALTH DEPT COPY: WHITE OWNER COPY (FINAL): YELLOW OWNER COPY (INITIAL): PINK