IREDELL COUNTY HEALTH DEPARTMENT

VILLE 704-878-5305 150.00 Paid 11/30 MOORESVILLE 704-664-5281

IMPROVEMENT PERMIT / AUTHORIZATION TO CONSTI[illegible] / OPERATION PERMIT / EXISTING SYSTEM INSPECT[illegible]

PERMIT# 12167 3 PIN# 4637372135 Kathy Todd DATE 9-3-0[illegible]

OWNER OR CONTRACTOR Joseph & Stephanie Hays PHONE: Business 902-1740 Home

ADDRESS 109 Hidden Ln Mooresville, NC 28117

LOCATION Hwy 50 West TL McCrary TL Tara Rd TL Hidden Ln lot on right

SUBDIVISION Hidden Cove BLOCK / SECTION LOT 10 LOT AREA SITE CLASS. PS DESIGN FLOW 360gpd L.T.A.R.

Septic Tank: 1000 Gallons; STB 312 Date 9-13-05
Pump Tank: 1000 Gallons; PT 27 Date 9-16-05
Pump Make: Gould Model WE05H Serial No.
Nitrification Field: No Fields 1 Square Feet ~900' Linear Feet ~300
No Lines 4 Trench Width 36" Max Trench Bottom Depth — Gravel Depth —

☒ New System ☐ Repair System Type: I, II, (III) IV, V, VI
System Description: Pump - Conventional
Repair System Description: Modified
Maintenance Agreement Required: ☐ Yes ☒ No

☒ House/Mod. Home No. Bedrooms 3
☐ Mobile Home No. Bathrooms 3
☐ Business No. Employees
☐ Other
☐ Slab ☐ Crawl Space ☒ Basement w/plumbing ☐ Basement wo/plumbing


Water Supply: ☒ Individual ☐ Public ☐ Community

Comments/Conditions: Existing Drainfield okay to reuse; appears to be functioning okay at time of inspection. Install Pressure Manifold (PM) & ST & PT

Comments/Conditions: Checked tanks 5/18/05
Pressure Checked 5/19/05 ~ 5ft to PL
Elect & alarm 10/19/05

Not to Scale

INITIAL SITE SKETCH

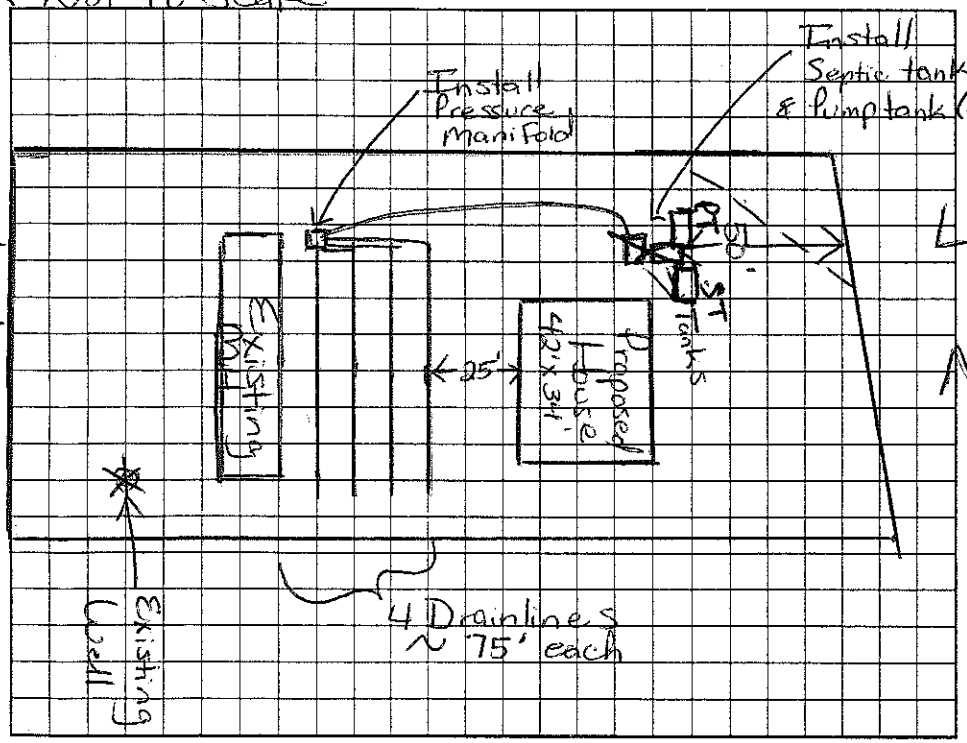

AS BUILT SKETCH

Permit can be suspended or revoked if any false information is supplied toward securing the permit/any unauthorized changes are made to the site/any unauthorized changes are made in the installation of the system. Improvement Permit with plat valid without expiration. Improvement Permit with site plan valid for sixty months. Authorization to Construct is valid for a period equal to that of Improvement Permit – not to exceed sixty months.

Signed: Kathy Todd date 9/10/04 Installed by: Joe Thompson

Improvement Permit by: Maria H. Dolan RS date 9/3/04 Operation Permit by: Maria H. Dolan RS date 10/19/05

Authorization to Construct by: Maria H. Dolan RS date 9/3/04 Existing System Inspection by: date

HEALTH DEPT. COPY: WHITE OWNER COPY (FINAL): YELLOW OWNER COPY (INITIAL): PINK