1.30

IREDELL COUNTY HEALTH DEPARTMENT

STATESVILLE 704-878-5305 MOORESVILLE 704-664-5281

IMPROVEMENT PERMIT / AUTHORIZATION TO CONSTRUCT / OPERATION PERMIT / EXISTING SYSTEM INSP

PERMIT# 24053 PIN# 2P8 A13 4637 37 3395 DATE 6/24

OWNER OR CONTRACTOR TONY HANEY PHONE: Business Home

ADDRESS 21316 SANDY COVE RD - CORNELIUS NC 28031

LOCATION McCRARY RD - TL TARA LN - TL HIDDEN COVE RD - AT END ON RT

SUBDIVISION HIDDEN COVE BLOCK / SECTION LOT 12 & 13 LOT AREA SITE CLASS. PS DESIGN FLOW 360 GPD L.T.A.R. .3 GPD/FT²

Septic Tank: 1000 Gallons; STB 825 Date

Pump Tank: 1000 Gallons; PT Date

Pump Make: Model Serial No.

Nitrification Field: No Fields 1 Square Feet 900 Linear Feet 300

No Lines 5@60' Trench Width 36" Max Trench Bottom Depth 36" Gravel Depth N/A

☑ New System ☐ Repair System Type: I, II, (III), IV, V, VI

System Description: PUMP CHAMBERS OR HOUSE PUMP PANEL

Repair System Description:

Maintenance Agreement Required: ☐ Yes ☑ No

☑ House/Mod. Home No. Bedrooms 3

☐ Mobile Home No. Bathrooms 2

☐ Business No. Employees

☐ Other


☐ Slab ☐ Crawl Space ☑ Basement w/plumbing ☐ Basement wo/plumbing

Water Supply: ☑ Individual ☐ Public ☐ Community

Comments:/Conditions:

Comments:/Conditions:

INITIAL SITE SKETCH

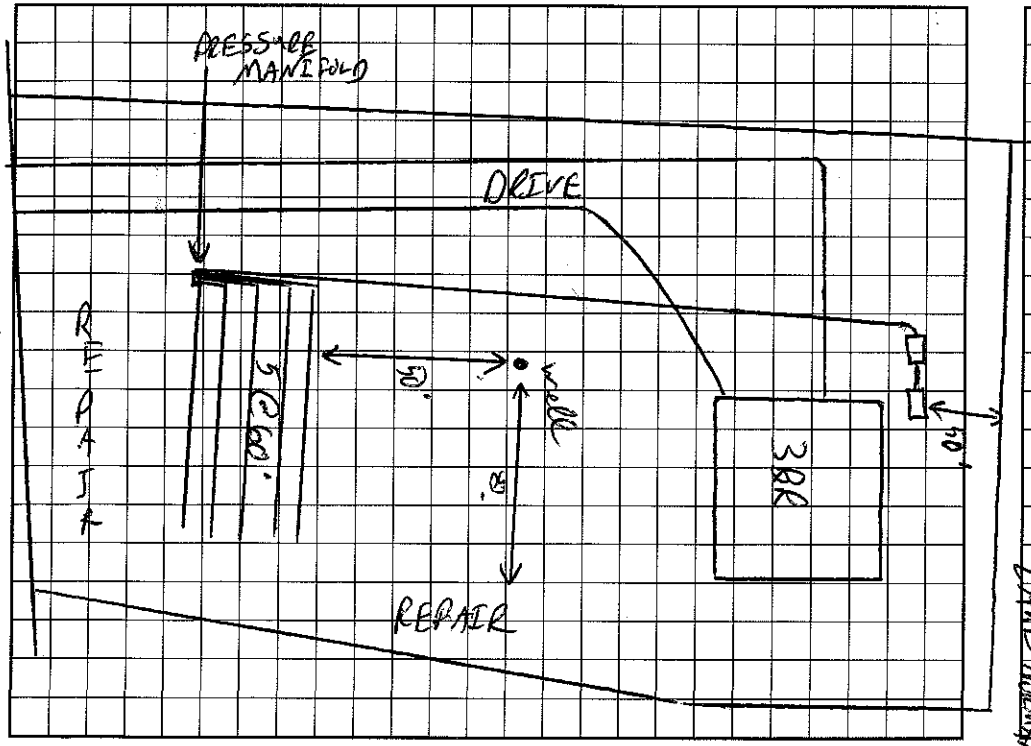

AS BUILT SKETCH

I understand that this permit can be suspended or revoked if any false information is supplied toward securing the permit/any unauthorized changes are made to the site/any unauthorized changes are made in the installation of the system. Improvement Permit with plat valid without expiration. Improvement Permit with site plan valid for sixty months. Authorization to Construct is valid for a period equal to that of Improvement Permit – not to exceed sixty months.

Signed: date 6/30/98 Installed by: WAYNE CLONTZ

Improvement Permit by: date 6/24/98 Operation Permit by: date 9/18/98

Authorization to Construct by: date 6/24/98 Existing System Inspection by: date

HEALTH DEPT. COPY: WHITE INSPECTION COPY (FINAL): GREEN OWNER COPY (FINAL): YELLOW INSPECTION COPY (INITIAL): PINK OWNER COPY (INITIAL): GOLD