IREDELL COUNTY HEALTH DEPARTMENT

STATESVILLE 704-878-5305 MOORESVILLE 704-664-5281

IMPROVEMENT PERMIT / AUTHORIZATION TO CONSTRUCT / OPERATION PERMIT / EXISTING SYSTEM INSPECTION

PERMIT# ~~12459~~ -12459 1 PIN# 4637-40-1685 DATE 11/24/04

OWNER OR CONTRACTOR ~~Danny Fisher~~ Ralph Bradford PHONE: Business 704 663-6905 Home

ADDRESS 6141 Main St. Salisbury NC 28144

LOCATION BSR, TR Blume, TR Patternote, at end

SUBDIVISION Patternote Cove BLOCK / SECTION LOT 1 LOT AREA 3.895AC SITE CLASS. PS DESIGN FLOW 720 L.T.A.R. 0.3

Septic Tank: 1500 Gallons; STB 338 Date 7-10-08

Pump Tank: 1500 Gallons; PT 417 Date 6-29-08

Pump Make: GOULDS Model PESIM Serial No.

Nitrification Field: No Fields 1 Square Feet 2400 Linear Feet 800'

No Lines 6@15' Trench Width 36" Max Trench Bottom Depth 36" Gravel Depth 12"

☒ New System ☐ Repair System Type: I, II, III, IV, V

System Description: PM ~~Conventional~~ 25% Red

Repair System Description: 25% Reduction

Maintenance Agreement Required: ☐ Yes ☒ No

☒ House/Mod. Home ☐ Mobile Home ☐ Business ☐ Other

No. Bedrooms 6 No. Bathrooms No. Employees

Water Supply: ☒ Individual ☐ Public ☐ Community


☐ Slab ☐ Crawl Space ☒ Basement w/plumbing ☐ Basement wo/plumbing

Comments/Conditions: 5@120'

1"=100'

Repair Area

INITIAL SITE SKETCH

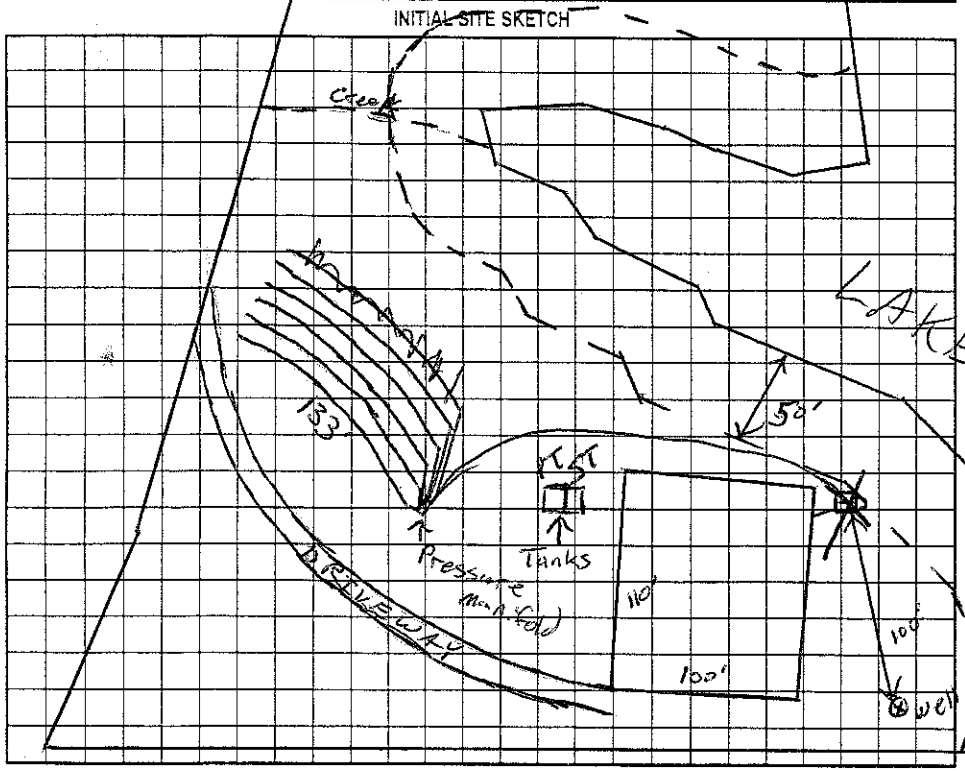

Comments/Conditions: 600ft of 25% Reduction

Okay to put tanks on other side of house.

Checked lines, & tanks 8/22/08

AS BUILT SKETCH

Permit can be suspended or revoked if any false information is supplied toward securing the permit/any unauthorized changes are made to the site/any unauthorized changes are made in the installation of the system. Improvement Permit with plat valid without expiration. Improvement Permit with site plan valid for sixty months. Authorization to Construct is valid for a period equal to that of Improvement Permit – not to exceed sixty months.

Signed: Tonay C Jarvis date 11-24-04 Installed by: Richard Abernathy

Improvement Permit by: RS date 11/24/04 Operation Permit by: REHS date 8-20-10

Authorization to Construct by: John E Alp date 4-10-07 Existing System Inspection by: date

HEALTH DEPT. COPY: WHITE OWNER COPY (FINAL): YELLOW OWNER COPY (INITIAL): PINK