IREDELL COUNTY HEALTH DEPARTMENT

STATESVILLE 704-878-5305 MOORESVILLE 704-664-5281

IMPROVEMENT PERMIT / AUTHORIZATION TO CONSTRUCT / OPERATION PERMIT / EXISTING SYSTEM INSPECTION

PERMIT# 122757 PIN# ~~4636 39 9719.042~~ 4637402020.000 DATE Nov 30, 04

OWNER OR CONTRACTOR Nichlock Dev. Corp. PHONE: Business _____ Home _____

ADDRESS 300 McGill Ave, Concord N.C. 28027

LOCATION Brawley School Rd. TR Blume TR Herons Gate TL Egrets Walk At end

SUBDIVISION Edgewater Park BLOCK / SECTION _____ LOT 42 LOT AREA 1.192 ac SITE CLASS PS DESIGN FLOW 480 gpd L.T.A.R. .25-.3

Septic Tank: 1000 Gallons; STB 794 Date 7/25/05

Pump Tank: 1000 Gallons; PT 2383 Date 7/26/05

Pump Make: _____ Model _____ Serial No. _____

Nitrification Field: No Fields 1 Square Feet 600/900 Linear Feet 320

No Lines 4 Trench Width 24" MIN 36" Max Trench Bottom Depth 30"

☑ New System ☐ Repair System Type: I, II, III, ⓘ V, VI

System Description: LPPPBPS

Repair System Description: LPPPBS

Maintenance Agreement Required: ☑ Yes ☐ No

☑ House/Mod. Home No. Bedrooms 4

☐ Mobile Home No. Bathrooms _____

☐ Business No. Employees _____

☐ Other _____


☐ Slab ☐ Crawl Space ☑ Basement w/plumbing ☐ Basement wo/plumbing

Water Supply: ☑ Individual ☐ Public ☐ Community

Comments:/Conditions: ok = 36" MW 9cc

Comments:/Conditions:

INITIAL SITE SKETCH 1" = 60'

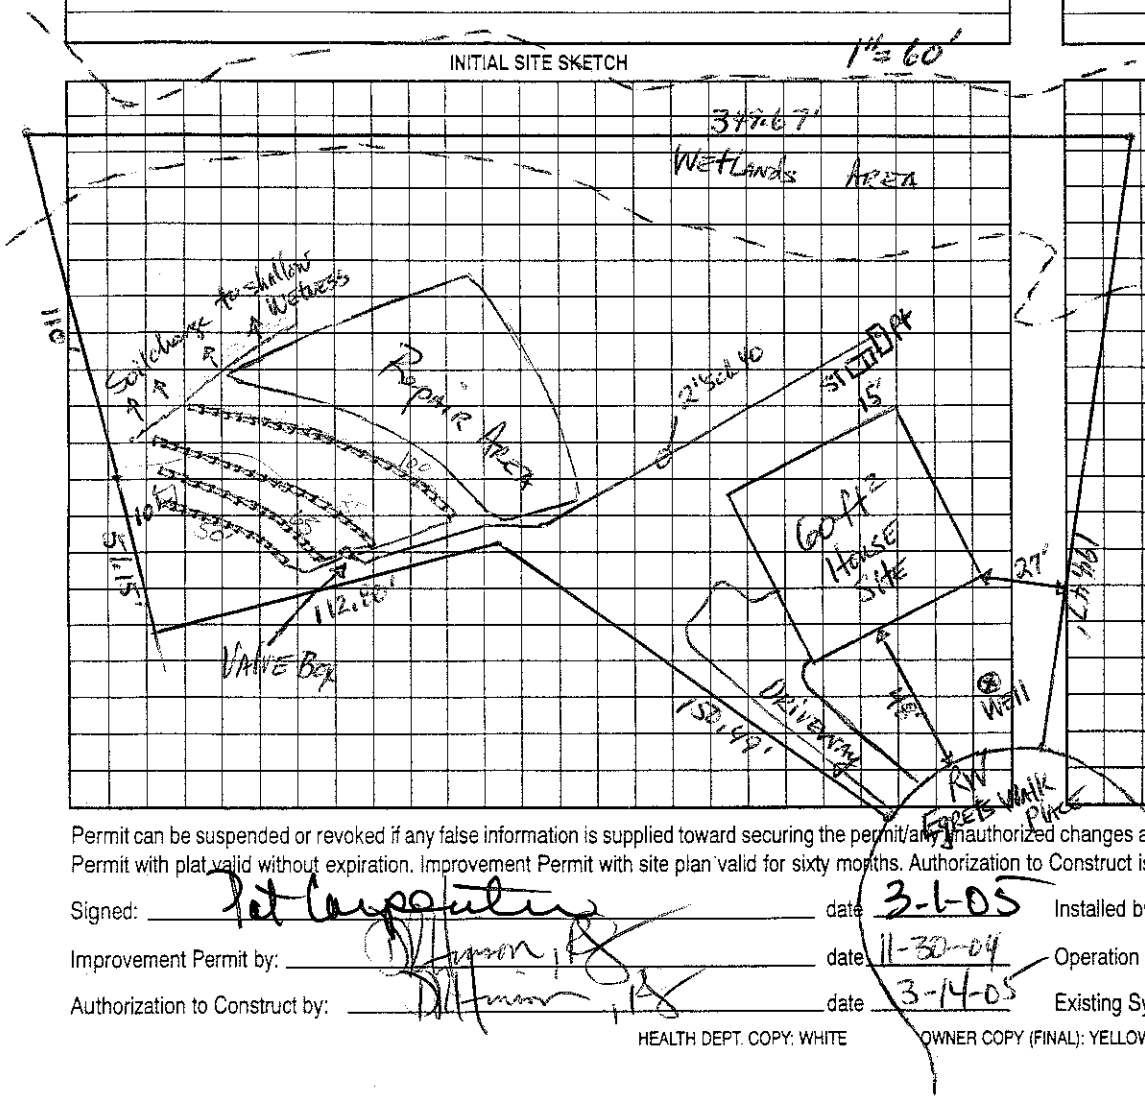

AS BUILT SKETCH

Permit can be suspended or revoked if any false information is supplied toward securing the permit/any unauthorized changes are made to the site/any unauthorized changes are made in the installation of the system. Improvement Permit with plat valid without expiration. Improvement Permit with site plan valid for sixty months. Authorization to Construct is valid for a period equal to that of Improvement Permit – not to exceed sixty months.

Signed: Pat Carpenter date 3-1-05 Installed by: Abernathy

Improvement Permit by: _____ date 11-30-04 Operation Permit by: _____ RS date 10/18/05

Authorization to Construct by: _____ date 3-14-05 Existing System Inspection by: _____ date _____

HEALTH DEPT. COPY: WHITE OWNER COPY (FINAL): YELLOW OWNER COPY (INITIAL): PINK