IREDELL COUNTY HEALTH DEPARTMENT - *ENVIRONMENTAL HEALTH* ☐ STATESVILLE OFFICE 704-878-5305 ☐ MOORESVILLE OFFICE 704-664-5281

IMPROVEMENT PERMIT / AUTHORIZATION TO CONSTRUCT / OPERATION PERMIT / EXISTING SYSTEM INSPECTION

PERMIT # PIN # 4637 40 4238 DATE

OWNER Frank Mattiace APPLICANT: PHONE: Home/Cell # 704 660-9249 Business # 704-746-2331

SITE ADDRESS 105 Egrets Walk Mace OWNER / APPLICANT ADDRESS

SITE DIRECTIONS Brawley School Rd TR Blume Rd TR Herron's Gate TL Egrets Walk Pl

SUBDIVISION Edgewater Park BLOCK / SECTION LOT # 44 LOT AREA .716 ac. DESIGN FLOW 480 gal L.T.A.R. .3

Septic Tank 1000 Gallons: STB 312 Date 10/18/04
Pump Tank Gallons: PT Date
Pump Make Model Serial #
No. Nitrification Fields: 2 No. Lines 4 Linear Feet 400'
Trench Width 36" Max. Trench Bottom Depth 36" Gravel Depth N/A

☐ New System ☐ Repair ☐ Expansion System Type I (II) III IV V VI
System Description: Existing Gravity -25% Reduction
Repair System Description: Gravity w/ 25% Reduction
Maintenance Agreement Required ☐ YES ☐ NO
☒ GRAVITY ☐ PRESSURE


☒ Residence No. Bedrooms 4
☐ Business No. Persons
☐ Other No. Employees
☐ Slab ☒ Crawl Space
☐ Basement w/plumbing ☐ Basement w/o plumbing

Water Supply: ☒ Private ☐ Public ☐ Community


Comments / Conditions: Existing Septic System Appears to be Functioning okay at the of inspection

Proposed Out Bldg. Must be at least 5FT from Septic Shall not impact existing Septic System

INITIAL SITE SKETCH

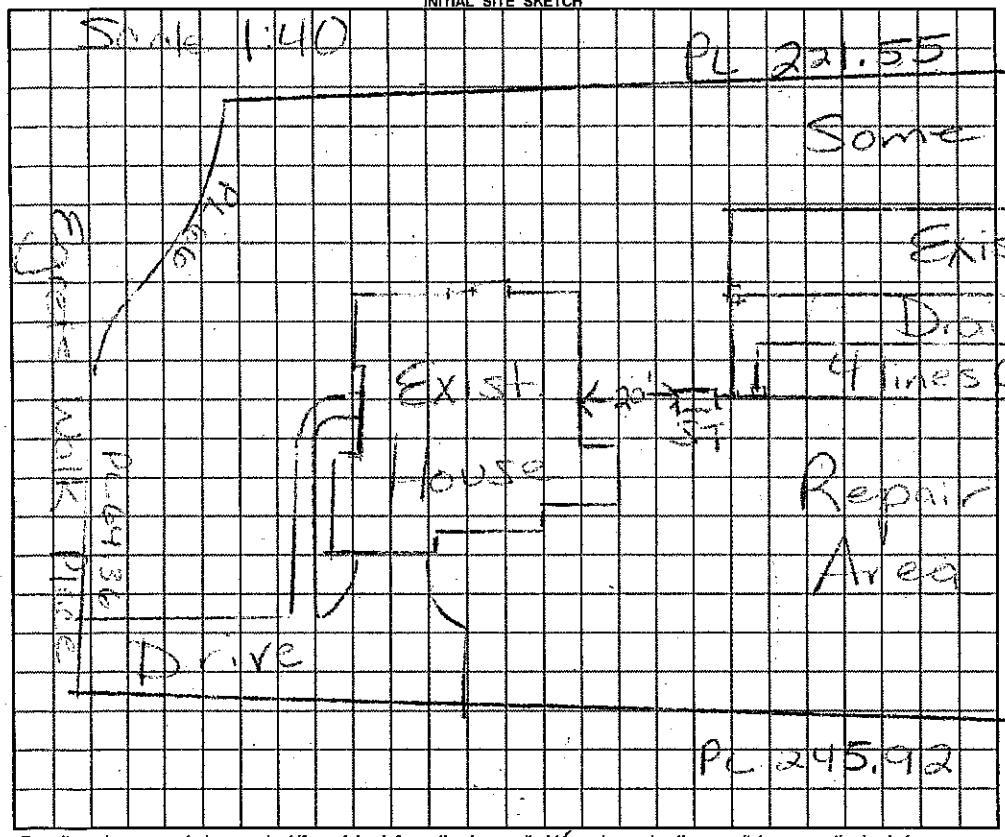

AS BUILT SKETCH

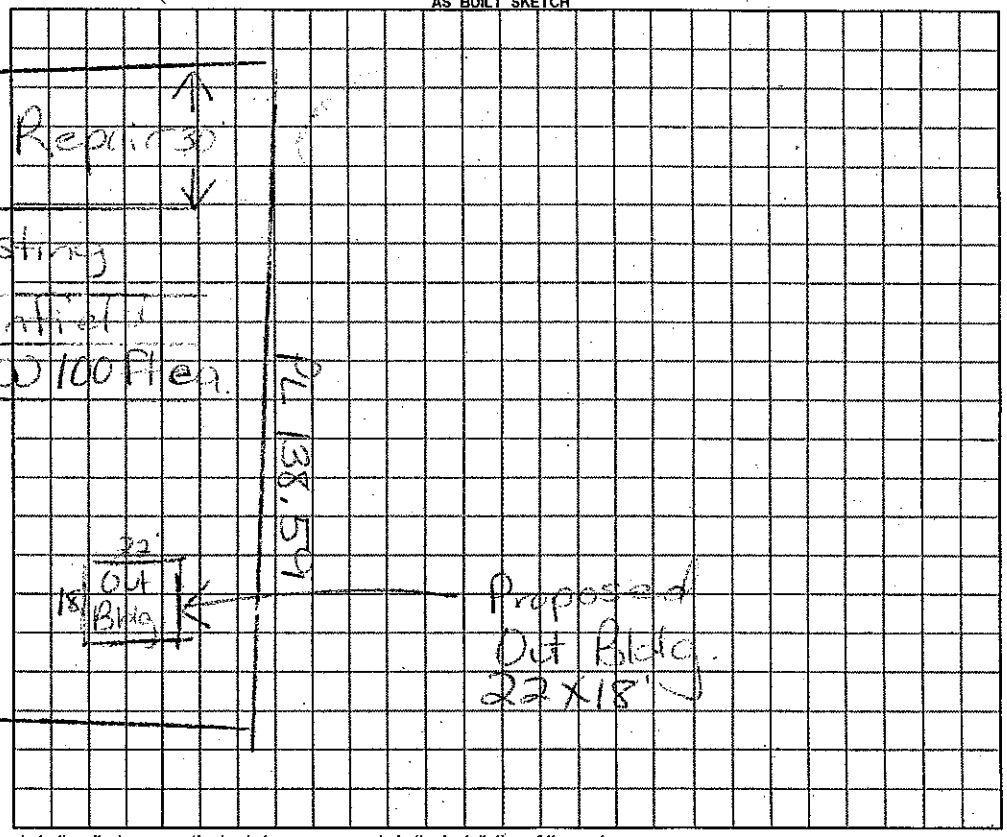

Permit can be suspended or revoked if any false information is supplied toward securing the permit / any unauthorized changes are made to the site / any unauthorized changes are made in the installation of the system.

☐ ***IMPROVEMENT PERMIT*** with plat valid without expiration. ☐ ***IMPROVEMENT PERMIT*** with ~~plat valid without expiration.~~ site plan valid 60 mo. ☐ ***AUTHORIZATION TO CONSTRUCT*** valid for period equal to IMPROVEMENT PERMIT--not to exceed 60 mo.

Owner / Applicant Signature: X Date 6/6/12 Installed by: R Abernathy on 3/22/05

IMPROVEMENT PERMIT by: ***REHS*** Date OPERATION PERMIT by: ***REHS*** Date

AUTHORIZATION TO CONSTRUCT by: ***REHS*** Date Existing System Inspected by: ***REHS*** Date 5/18/20

YOU SHOULD CONTACT A LOCATOR SERVICE PRIOR TO ANY EXCAVATION

White Copy – Environmental Health YELLOW COPY (Final) Owner / Applicant PINK COPY (Initial) Owner / Applicant