IREDELL COUNTY HEALTH DEPARTMENT

STATESVILLE 704-878-5305 MOORESVILLE 704-664-5281

IMPROVEMENT PERMIT / AUTHORIZATION TO CONSTRUCT / OPERATION PERMIT / EXISTING SYSTEM INSPECTION

180.00 to a,g

PERMIT# 122764 PIN# ~~4636-39-9719.000~~ 4637-40-4228 DATE Jan 20, 05

OWNER OR CONTRACTOR Niblock Dev Corp / Frank Mattiace PHONE: Business _____ Home _____

ADDRESS 300 McGill Ave, N.W. Concord, N.C. 28027

LOCATION Brawley School TR Blume TR Herron's Gate TL Egrets Walk on Right near/at end

SUBDIVISION Edgewater Park BLOCK / SECTION 3 LOT 44 LOT AREA .716 ac SITE CLASS. PS DESIGN FLOW 480 gpd L.T.A.R. .3

Septic Tank: 1000 Gallons; STB 312 Date 12/18/04
Pump Tank: _____ Gallons; PT _____ Date _____
Pump Make: _____ Model _____ Serial No. _____
Nitrification Field: No Fields 2 Square Feet 1200 Linear Feet 400
No Lines 2+2 Trench Width 36" Max Trench Bottom Depth 36" Gravel Depth NA

☑ New System ☐ Repair System Type: I, II, III, IV, V, VI
System Description: Gravity 25% Reduction
Repair System Description: Grav/pumped 25% Reduction
Maintenance Agreement Required: ☐ Yes ☐ No

☑ House/Mod. Home No. Bedrooms 4
☐ Mobile Home No. Bathrooms ____
☐ Business No. Employees ____
☐ Other _____

☐ Slab ☑ Crawl Space ☐ Basement w/plumbing ☐ Basement wo/plumbing


Water Supply: ☑ Individual ☐ Public ☐ Community

Comments:/Conditions:
Do not cut / lower house site

Comments:/Conditions: ST 20' off House, 8' off Deck

1"=50'

INITIAL SITE SKETCH

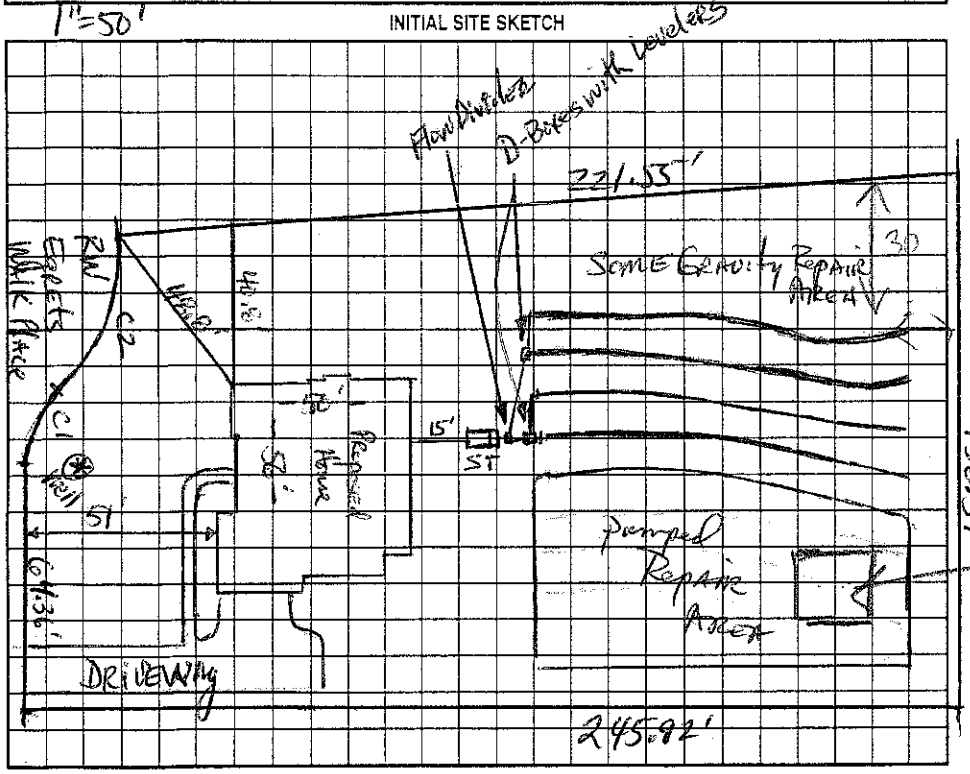

AS BUILT SKETCH

Infiltrators Installed

Location of the proposed Shed addition does not appear to impact the existing on-site septic system.**NOTE: Keep Bldg at least 5ft from Septic System

Date: 3/26/13 REHS

ICHD-Environmental Health Division

Permit can be suspended or revoked if any false information is supplied toward securing the permit/any unauthorized changes are made to the site/any unauthorized changes are made in the installation of the system. Improvement Permit with plat valid without expiration. Improvement Permit with site plan valid for sixty months. Authorization to Construct is valid for a period equal to that of Improvement Permit – not to exceed sixty months.

Signed: Pat Caughron date 12/4/05 Installed by: Abernathy

Improvement Permit by: _____ RS date Jan 20, 05 Operation Permit by: _____ RS date 3/22/05

Authorization to Construct by: _____ RS date Jan 20, 05 Existing System Inspection by: _____ date _____

HEALTH DEPT. COPY: WHITE OWNER COPY (FINAL): YELLOW OWNER COPY (INITIAL): PINK