IREDELL COUNTY HEALTH DEPARTMENT

STATESVILLE 704-878-5305 MOORESVILLE 704-664-5281

IMPROVEMENT PERMIT / AUTHORIZATION TO CONSTRUCT / OPERATION PERMIT / EXISTING SYSTEM INSPECTION

PERMIT# 122807 PIN# ~~4636-31-7776~~ 4637-40-9722 DATE Jan 3, 2005

OWNER OR CONTRACTOR Wyatt Development PHONE: Business Home

ADDRESS 300 McNeil Ave, NW Conover, N.C. 28627

LOCATION Brawley Sch Rd. TR Blume TR Hoover's Gate DR to end across street on Egrets Walk N.

SUBDIVISION Edgewater Park BLOCK / SECTION LOT 48 LOT AREA 1.017ac SITE CLASS. PS DESIGN FLOW 480gpd L.T.A.R. .25-.3

Septic Tank: 1000 Gallons; STB 794 Date 5/23/06

Pump Tank: 1000 Gallons; PJ 283 Date 7/6/06

Pump Make: Goulds Model PC51M Serial No.

Nitrification Field: No Fields 1 Square Feet 640/960 Linear Feet 320(332)

No Lines 5 Trench Width 24"=640 36"=960 Max Trench Bottom Depth 36" Gravel Depth NA

☑ New System ☐ Repair System Type: I, II, III, (IV), V, VI

System Description: LPD PPDS

Repair System Description: LPD PPDS

Maintenance Agreement Required: ☑ Yes ☐ No

☑ House/Mod. Home No. Bedrooms 4

☐ Mobile Home No. Bathrooms

☐ Business No. Employees

☐ Other

☐ Slab ☑ Crawl Space ☐ Basement w/plumbing ☐ Basement wo/plumbing

Water Supply: ☑ Individual ☐ Public ☐ Community

Comments/Conditions: * In Line filter Required in pump tank


3/28/06 Reviewed Building plan & Site plan, essentially in compliance with I.P.

Comments/Conditions: * Drive on other side.


Well placed 25' in front of house SM

Tanks, Lines, Pressure (As Built)

INITIAL SITE SKETCH 1"=60'

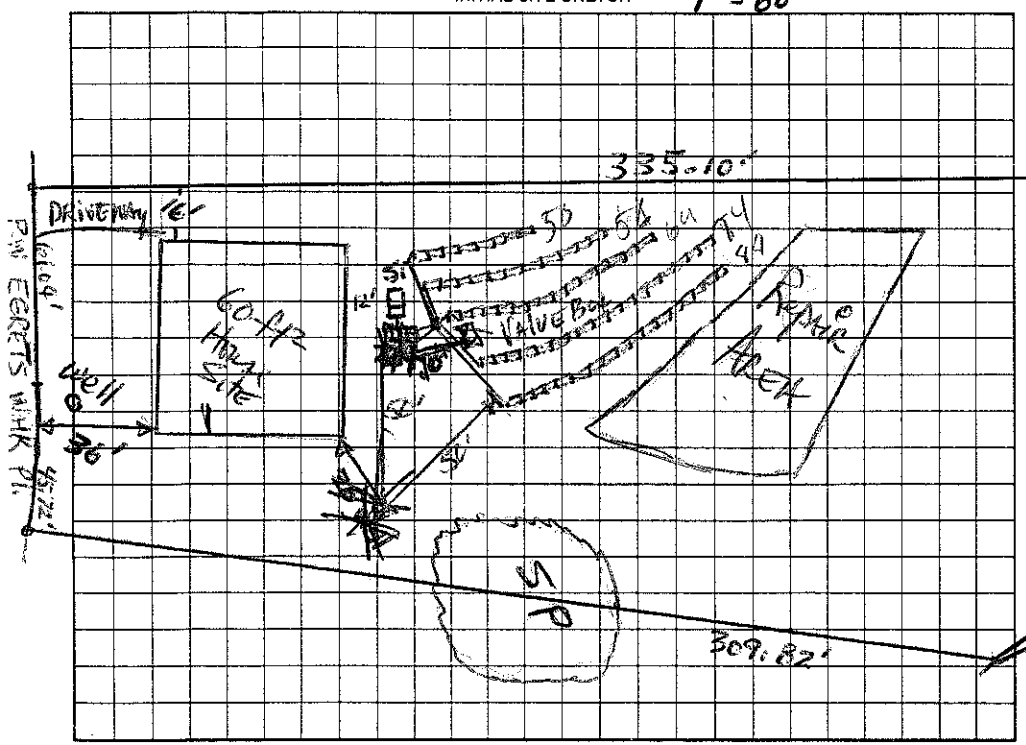

AS BUILT SKETCH

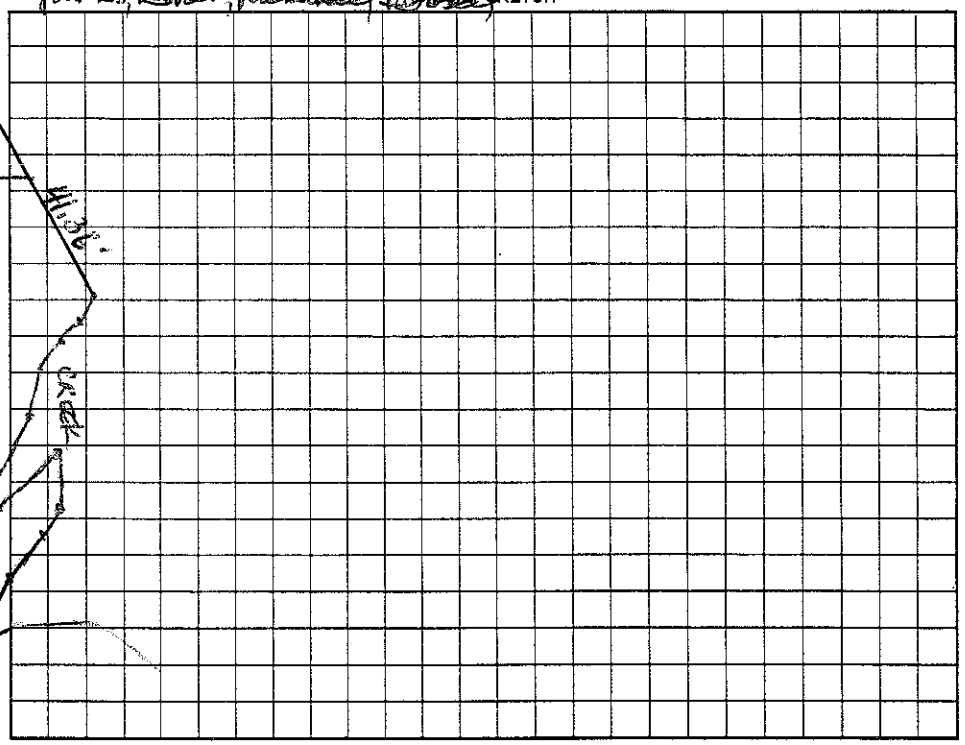

Permit can be suspended or revoked if any false information is supplied toward securing the permit/any unauthorized changes are made to the site/any unauthorized changes are made in the installation of the system. Improvement Permit with plat valid without expiration. Improvement Permit with site plan valid for sixty months. Authorization to Construct is valid for a period equal to that of Improvement Permit – not to exceed sixty months.

Signed: Pat Carpenter date 3-1-05 Installed by: Larry Hinkle

Improvement Permit by: [signature] date Jan 3, 05 Operation Permit by: [signature] date 8/24/06

Authorization to Construct by: [signature] date 3/28/06 Existing System Inspection by: date

HEALTH DEPT. COPY: WHITE OWNER COPY (FINAL): YELLOW OWNER COPY (INITIAL): PINK