IREDELL COUNTY HEALTH DEPARTMENT

STATESVILLE 704-878-5305 MOORESVILLE 704-664-5281

IMPROVEMENT PERMIT / CERTIFICATE OF COMPLETION / OPERATION PERMIT / EXISTING SYSTEM INSPECTION

PROPERTY DESCRIPTION NO. 16665 DATE July 21, '93 TAX MAP NO. 2K6A205

OWNER OR CONTRACTOR Julian D'Amico PHONE: Business Home 4637-41-6241

ADDRESS

LOCATION 1600 SR 1250 (Oak Tree Rd) NEAR END on Right

SUBDIVISION Crescent / Lake Norman BLOCK / SECTION 9 LOT [illegible] LOT AREA 150x193 SITE CLASS. L.T.A.R.

1497

Water Supply: ☑ Individual ☐ Community ☐ Public

Septic Tank: EXISTING Gallons; STB Date

Pump Tank: Gallons; PT Date

Nitrification Field: No Fields Existing Square Feet Linear Feet

No Lines Trench Width Trench Depth Gravel Depth

☐ New System ☐ Repair System Type: I, II, III, IV, V, VI

System Description: LPS (conventional)

Repair System Description: SAME OR Type 3

Maintenance Agreement Required: ☒ Yes ☐ No if repaired Type IV

☑ House/Mod. Home No. Bedrooms 3

☐ Mobile Home No. Bathrooms 2

☐ Business No. Employees

☐ Other

☐ Slab ☑ Crawl Space ☐ Basement w/plumbing ☐ Basement wo/plumbing

Garbage Disposal: ☑ Yes ☐ No

Auto. Dishwasher: ☑ Yes ☐ No

Auto. Washing Machine: ☑ Yes ☐ No


Other

Comments Replacing MH w/ 3 bedroom house. No sign of malfunction w/ Septic System

Lake Norman

INITIAL SITE SKETCH

AS BUILT SKETCH

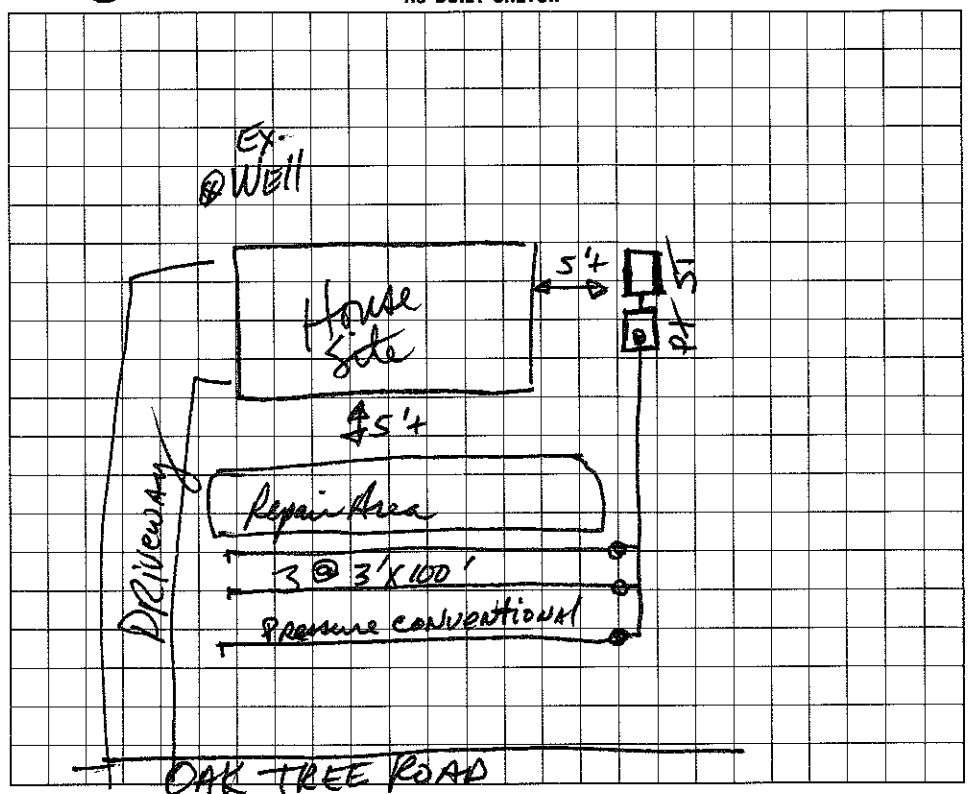

I understand that this permit can be suspended or revoked if any false information is supplied toward securing the permit/any unauthorized changes are made to the site/any unauthorized changes are made in the installation of the system. Improvement Permit is valid for 60 months from date of issuance.

Signed:

Improvement Permit by: date

Existing System Inspection by: date 7/21/93

Installed by:

Certificate of Completion by: date

Operation Permit by: date

HEALTH DEPT. COPY: WHITE INSPECTION COPY (FINAL): GREEN OWNER COPY (FINAL): YELLOW INSPECTION COPY (INITIAL): PINK OWNER COPY (INITIAL): GOLD