IREDELL COUNTY HEALTH DEPARTMENT

Authorization to Construct

463743 1365

STATESVILLE 704-878-5305 MOORESVILLE 704-664-5281 Brotherton 5/0

IMPROVEMENT PERMIT / ~~CERTIFICATE OF COMPLETION~~ / OPERATION PERMIT / EXISTING SYSTEM INSPECTION

PROPERTY DESCRIPTION NO. 22783 DATE 1/10/96 TAX MAP NO. 2K 15 A 142 Watershed: ☒ Yes ☐ No

OWNER OR CONTRACTOR Doyle R. Hatcock PHONE: Business _____ Home 664-6761 Ray Short

ADDRESS 418 Oak Tree Rd. Mooresville NC 28115

LOCATION Oak Tree Rd. ~~Bradshaw Rd.~~ bear (L) to 5th Lt on (R)

SUBDIVISION TIMBER LN. SHORES BLOCK / SECTION _____ LOT 142 LOT AREA 1.33 Ac SITE CLASS. PS DESIGN FLOW 480 L.T.A.R. .3

Septic Tank: 1000 Gallons; STB 794 Date _____

Pump Tank: 1000 Gallons; PT 27 Date _____

Pump Make: HYDROWATK Model SHEF50M1 Serial No. 5-99 270 ~~275~~

Nitrification Field: No Fields 1 Square Feet 1600 Linear Feet (533) ~~575~~

No Lines X 5 Trench Width 24" Max Trench Bottom Depth 36" Gravel Depth 6"STONE

☒ New System ☐ Repair System Type: I, II, (III) IV, V, VI

System Description: Pres. Manifold - Panels

Repair System Description: Same

Maintenance Agreement Required: ☒ Yes ☐ No 5/YR.

☒ House/Mod. Home ☐ Mobile Home ☐ Business ☐ Other

No. Bedrooms 4 No. Bathrooms 3 No. Employees _____

☐ Slab ☐ Crawl Space ☒ Basement w/plumbing ☐ Basement wo/plumbing


Water Supply: ☒ Individual ☐ Community ☐ Public

Comments:

160' CenTeR

50'

INITIAL SITE SKETCH

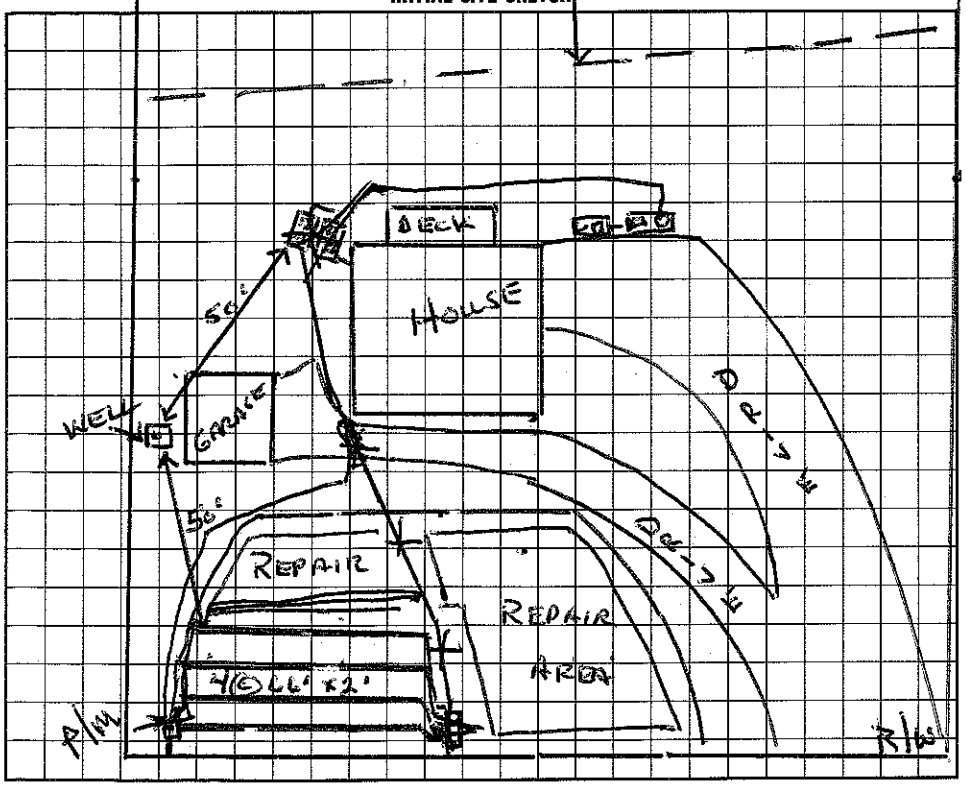

Comments:

AS BUILT SKETCH

I understand that this permit can be suspended or revoked if any false information is supplied toward securing the permit/any unauthorized changes are made to the site/any unauthorized changes are made in the installation of the system.

Signed: X Ray Short

Installed by: Curt Dunning

Improvement Permit by: Wesley Sparks R.S. date 1/10/96

Certificate of Completion by: Wesley Sparks R.S. date 10/18/99

~~Existing System Inspection by:~~ Authorized Agent Wesley Sparks R.S. date 1/10/96

Operation Permit by: Wesley Sparks R.S. date 10/18/99

HEALTH DEPT. COPY: WHITE INSPECTION COPY (FINAL): GREEN OWNER COPY (FINAL): YELLOW INSPECTION COPY (INITIAL): PINK OWNER COPY (INITIAL): GOLD