IREDELL COUNTY HEALTH DEPARTMENT - *ENVIRONMENTAL HEALTH* ☐ STATESVILLE OFFICE 704-878-5305 ☒ MOORESVILLE OFFICE 704-664-5281

IMPROVEMENT PERMIT / AUTHORIZATION TO CONSTRUCT / OPERATION PERMIT / EXISTING SYSTEM INSPECTION

PERMIT # 168572 PIN # 4637 43 5432 DATE October 13, 2011

OWNER Joe & Diane Ducey APPLICANT: Morse Homes PHONE: Home/Cell # 704-425-2219 Business #

SITE ADDRESS 388 Oak Tree Rd. OWNER / APPLICANT ADDRESS same

SITE DIRECTIONS Brawley School Rd TR Oak Tree bear left at curve site on right

SUBDIVISION Timberlane Shores BLOCK / SECTION LOT # 1 LOT AREA DESIGN FLOW 360gpd L.T.A.R. .3gpd/ft²

Septic Tank Existing Gallons: STB Date
Pump Tank Gallons: P T Date
Pump Make Model Serial #
No. Nitrification Fields: No. Lines Linear Feet
Trench Width Existing Max. Trench Bottom Depth Gravel Depth

☐ New System ☐ Repair ☐ Expansion System Type I II (III) IV V VI
System Description: Existing PPBPS
Repair System Description: PPBPS
Maintenance Agreement Required ☐ YES ☒ NO
☒ GRAVITY ☐ PRESSURE

☒ Residence No. Bedrooms 3
☐ Business No. Persons
☒ Other Porch No. Employees
☐ Slab ☐ Crawl Space
☐ Basement w/plumbing ☐ Basement w/o plumbing


Water Supply
☒ Private
☐ Public
☐ Community

Comments / Conditions

- Septic system field and repair area shall not be located under paved areas
- M. Athanas & Assoc. contributed to this evaluation

INITIAL SITE SKETCH

AS BUILT SKETCH

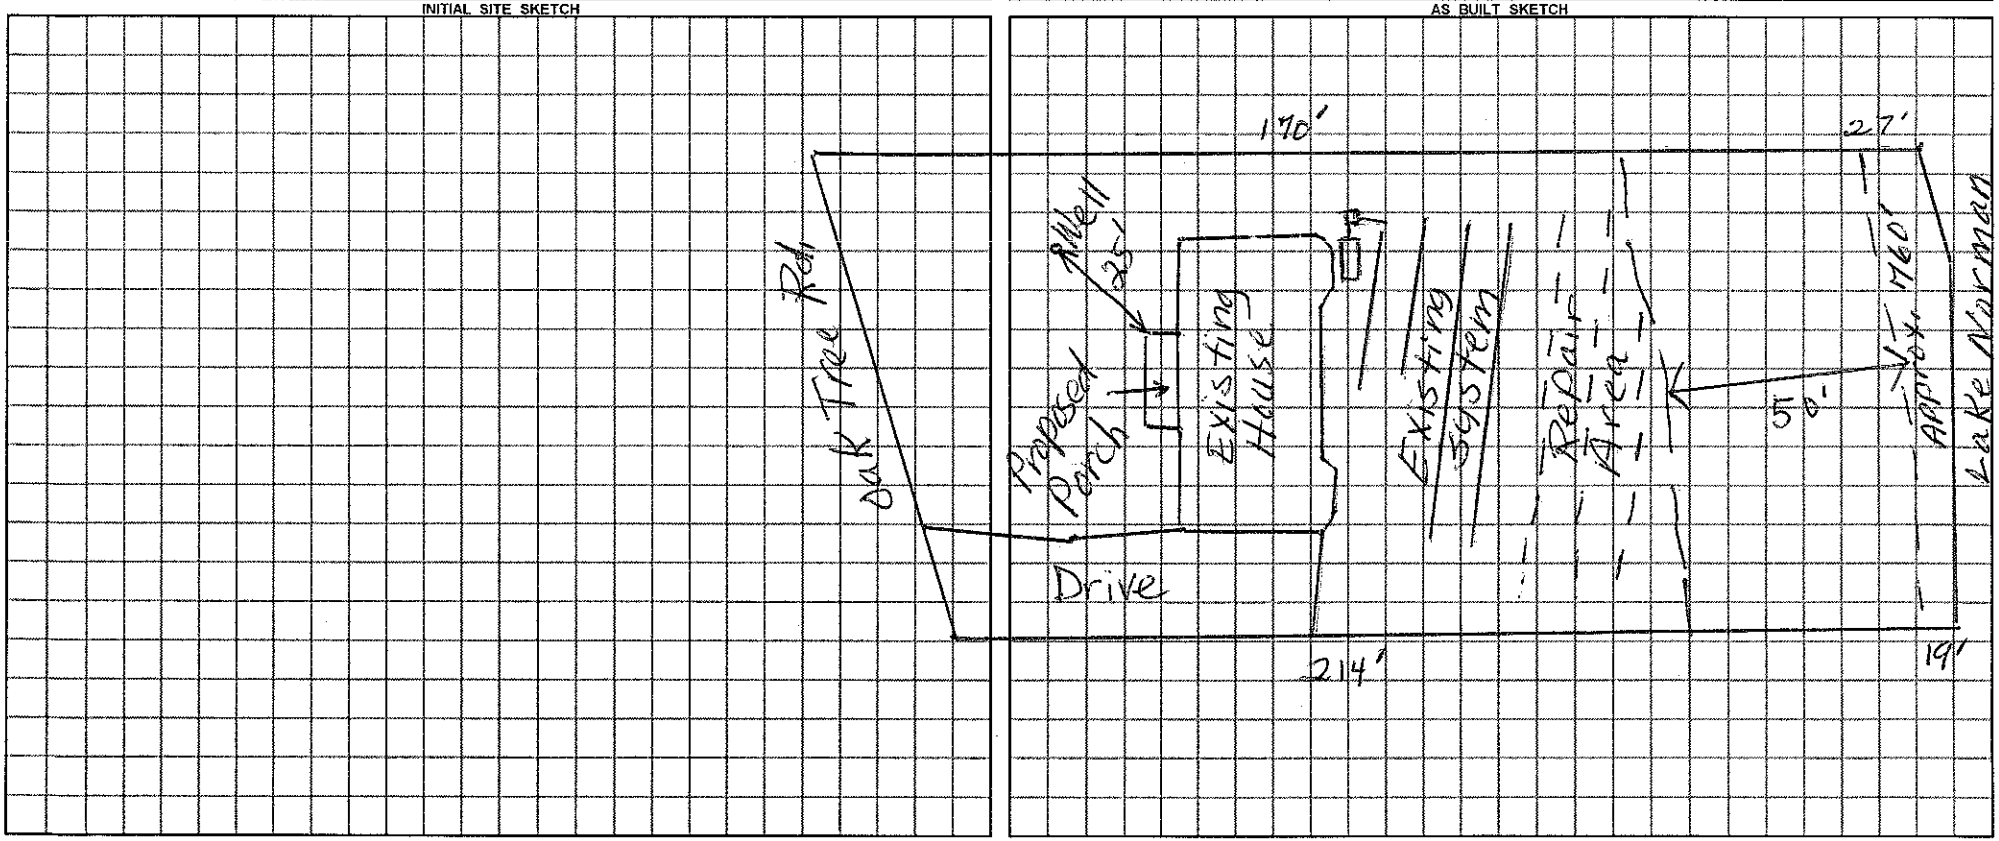

Permit can be suspended or revoked if any false information is supplied toward securing the permit / any unauthorized changes are made to the site / any unauthorized changes are made in the installation of the system.

☐ ***IMPROVEMENT PERMIT*** with plat valid without expiration. ☐ ***IMPROVEMENT PERMIT*** with ~~plat valid without expiration.~~ site plan valid 60 mo. ☐ ***AUTHORIZATION TO CONSTRUCT*** valid for period equal to IMPROVEMENT PERMIT--not to exceed 60 mo.

Owner / Applicant Signature: Date 10/13/11 Installed by:

IMPROVEMENT PERMIT by: REHS Date

AUTHORIZATION TO CONSTRUCT by: REHS Date

OPERATION PERMIT by: REHS Date

Existing System Inspected by: Judy Melville REHS Date 10-13-11

YOU SHOULD CONTACT A LOCATOR SERVICE PRIOR TO ANY EXCAVATION

White Copy – Environmental Health YELLOW COPY (Final) Owner / Applicant PINK COPY (Initial) Owner / Applicant