(2:30) (3:00) 704-428-0444

IREDELL COUNTY HEALTH DEPARTMENT

STATESVILLE 704-878-5305 MOORESVILLE 704-664-5281

IMPROVEMENT PERMIT / CERTIFICATE OF COMPLETION / OPERATION PERMIT / EXISTING SYSTEM INSPECTION

PROPERTY DESCRIPTION NO. 22488 DATE Jan. 30, '96 TAX MAP NO. 2K-15A5 4637 43 9610 Watershed: ☑ Yes ☐ No

OWNER OR CONTRACTOR J. Morris Wilson PHONE: Business _____ Home _____ WS4CA

ADDRESS 488 Laurel Cove Rd. Statesville

LOCATION Brawley Sch Rd. TR OAK TREE Rd. on Right

SUBDIVISION Timberlane Shores BLOCK / SECTION _____ LOT 5 LOT AREA .53Ac. SITE CLASS. PS per 1996 DESIGN FLOW 360gpd L.T.A.R. 1.3

Septic Tank: 1000 Gallons; STB 786 Date 6/20/96

Pump Tank: 1000 Gallons; PT 39 Date 8/10/96

Pump Make: ZOELLER Model 163-5 Serial No. _____

Nitrification Field: No Fields 1 Square Feet _____ Linear Feet 200+

No Lines 4 Trench Width 24" Max Trench Bottom Depth 30" Gravel Depth N/A

☑ New System ☐ Repair System Type: I, II, III, IV, V, VI

System Description: pressure manifold panel block

Repair System Description: Same

Maintenance Agreement Required: ☐ Yes ☑ No

☑ House/Mod. Home No. Bedrooms 3

☐ Mobile Home No. Bathrooms 2½

☐ Business No. Employees ____

☐ Other _____

☐ Slab ☑ Crawl Space ☑ Basement w/plumbing ☐ Basement wo/plumbing

Water Supply: ☑ Individual ☐ Community ☐ Public

Comments:


Comments: PARTIAL

TANKS - UPPER 3 LINES CHECKED 10/15/96 CBF

LAST LINE & PRESSURE CHECKED 10/16/96 CBF

ELECTRICAL CHECKED _____.

INITIAL SITE SKETCH

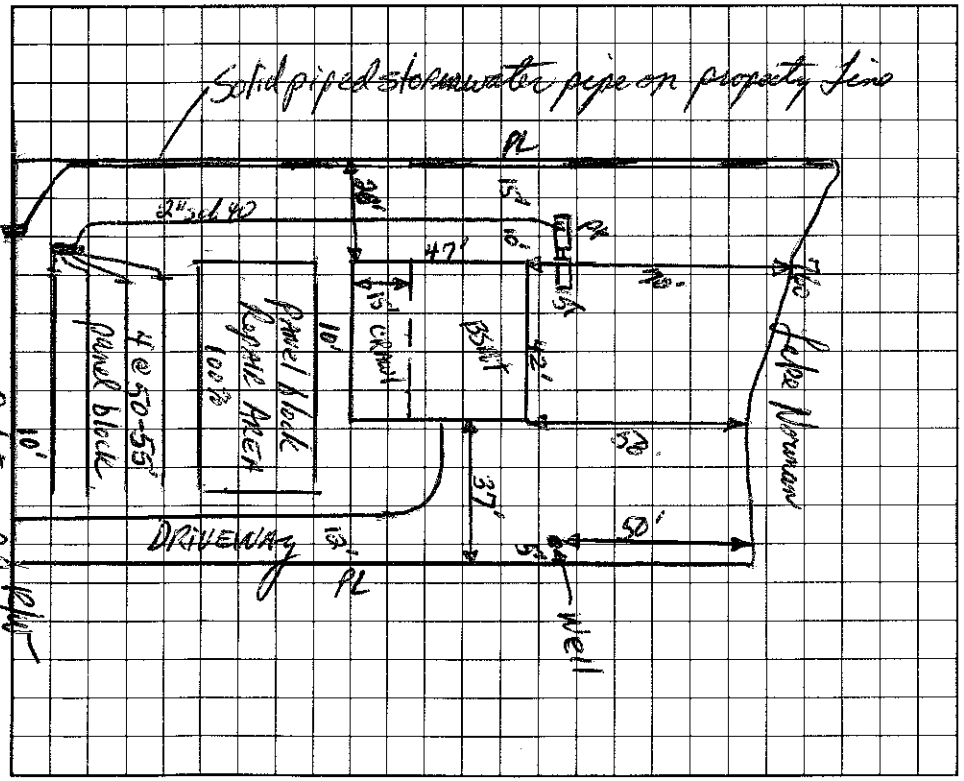

AS BUILT SKETCH

I understand that this permit can be suspended or revoked if any false information is supplied toward securing the permit/any unauthorized changes are made to the site/any unauthorized changes are made in the installation of the system.

Signed: _____

Improvement Permit by: Authorized date Jan 30, '96

~~Existing System Inspection by:~~ _____ date Jan 30, '96

Installed by: CATAWBA SEPTIC TANKS -

Certificate of Completion by: _____ date _____

Operation Permit by: _____ date 10/18/96

to continued

HEALTH DEPT. COPY: WHITE INSPECTION COPY (FINAL): GREEN OWNER COPY (FINAL): YELLOW INSPECTION COPY (INITIAL): PINK OWNER COPY (INITIAL): GOLD