IREDELL COUNTY HEALTH DEPARTMENT

STATESVILLE 704-878-5305 · MOORESVILLE 704-664-5281

IMPROVEMENT PERMIT / AUTHORIZATION TO CONSTRUCT / OPERATION PERMIT / EXISTING SYSTEM INSPECTION

PERMIT# 103603 PIN# 4637-44-0544 DATE 11/30/01

OWNER OR CONTRACTOR Gary Trent PHONE: Business Home 704-664-1017

ADDRESS 115 Michigan Dr. Apt B Mooresville NC 28117

LOCATION 150W, TL Poole, TR Whipporwill, on Rt

SUBDIVISION Whipporwill Woods BLOCK / SECTION ± LOT 38 LOT AREA 0.87 Ac SITE CLASS. R5 DESIGN FLOW 360 L.T.A.R. 055

Septic Tank: 1000 Gallons; STB 794 Date 11/19/01

Pump Tank: Gallons; PT Date

Pump Make: Model Serial No.

Nitrification Field: No Fields 1 Square Feet 1200 Linear Feet 400

No Lines 5 Trench Width 36" Max Trench Bottom Depth 36" Gravel Depth 12"

☒ New System ☐ Repair System Type: I, II, III, IV, V, VI

System Description: Gravity, Conventional

Repair System Description: same

Maintenance Agreement Required: ☐ Yes ☒ No

☒ House/Mod. Home ☐ Mobile Home ☐ Business ☐ Other

No. Bedrooms 3 No. Bathrooms 2½ No. Employees


Water Supply: ☒ Individual ☐ Public ☐ Community

☐ Slab ☒ Crawl Space ☐ Basement w/plumbing ☐ Basement wo/plumbing


Comments:/Conditions:

Comments:/Conditions:

INITIAL SITE SKETCH

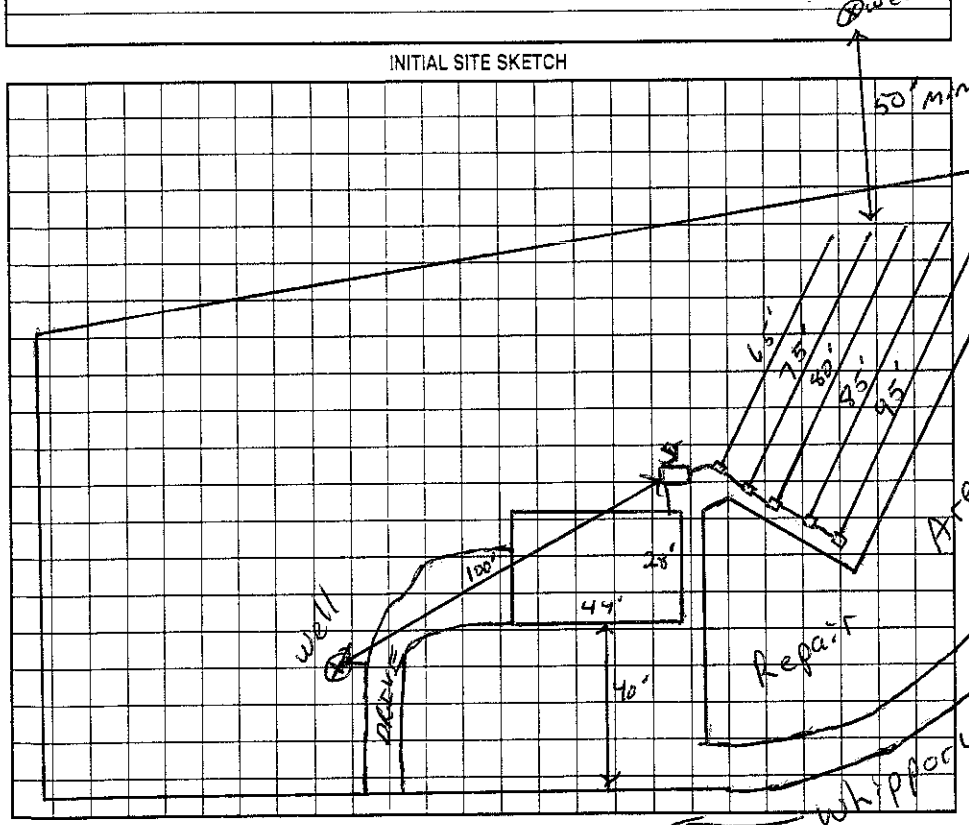

AS BUILT SKETCH

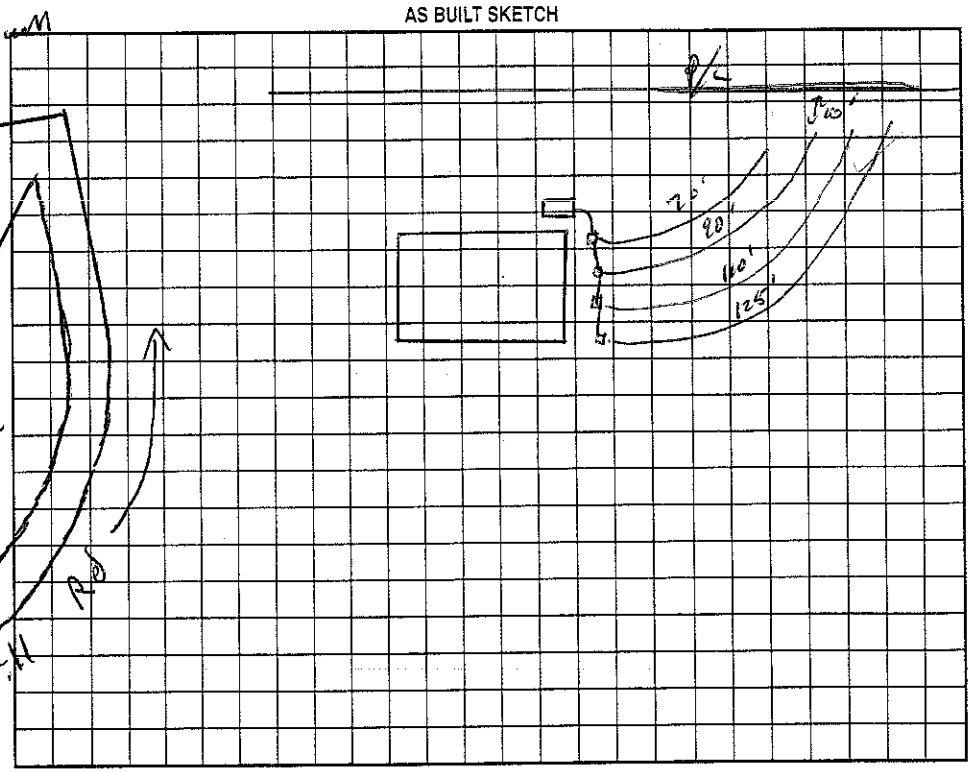

Permit can be suspended or revoked if any false information is supplied toward securing the permit/any unauthorized changes are made to the site/any unauthorized changes are made in the installation of the system. Improvement Permit with plat valid without expiration. Improvement Permit with site plan valid for sixty months. Authorization to Construct is valid for a period equal to that of Improvement Permit – not to exceed sixty months.

Signed: Gary N Trent date 12/4/01 Installed by: Tucker Grading

Improvement Permit by: RSI date 11/30/01 Operation Permit by: RS date 2/18/02

Authorization to Construct by: RSI date 11/30/01 Existing System Inspection by: date

HEALTH DEPT. COPY: WHITE OWNER COPY (FINAL): YELLOW OWNER COPY (INITIAL): PINK