IREDELL COUNTY HEALTH DEPARTMENT

STATESVILLE 704-878-5305 MOORESVILLE 704-664-5281

IMPROVEMENT PERMIT / CERTIFICATE OF COMPLETION / OPERATION PERMIT / EXISTING SYSTEM INSPECTION

PROPERTY DESCRIPTION NO. 19759 DATE Nov 29, '94 TAX MAP NO. 2f14A39 4637440769 Watershed: ☑ Yes ☐ No

OWNER OR CONTRACTOR Frank Burke Homes PHONE: Business 545 2972 Home LW WS II

ADDRESS 5308 Barnsdale Lane, Charlotte 28227

LOCATION 150 W TL Dolie TR Whippoorwill Rd ~1/2 mile on Rt.

SUBDIVISION Whippoorwill BLOCK / SECTION LOT 39 LOT AREA 1.17Ac SITE CLASS PS DESIGN FLOW 360 gpd L.T.A.R. .3

Septic Tank: 1000 Gallons; STB 325 Date 3/12/95

Pump Tank: Gallons; PT Date

Pump Make: Model Serial No.

Nitrification Field: No Fields 1 Square Feet 1200 Linear Feet 400

No Lines 4 Trench Width 36" Max Trench Bottom Depth 30" Gravel Depth 12"

☑ New System ☐ Repair System Type: I, II, III, IV, V, VI

System Description: gravity Conventional

Repair System Description: Same

Maintenance Agreement Required: ☐ Yes ☑ No

☑ House/Mod. Home No. Bedrooms 3

☐ Mobile Home No. Bathrooms 3

☐ Business No. Employees

☐ Other


☐ Slab ☑ Crawl Space ☐ Basement w/plumbing ☐ Basement wo/plumbing

Water Supply: ☑ Individual ☐ Community ☐ Public

Comments: follow contour w/ laterals

Comments: Property lines verified from survey. Permit should be valid.

INITIAL SITE SKETCH

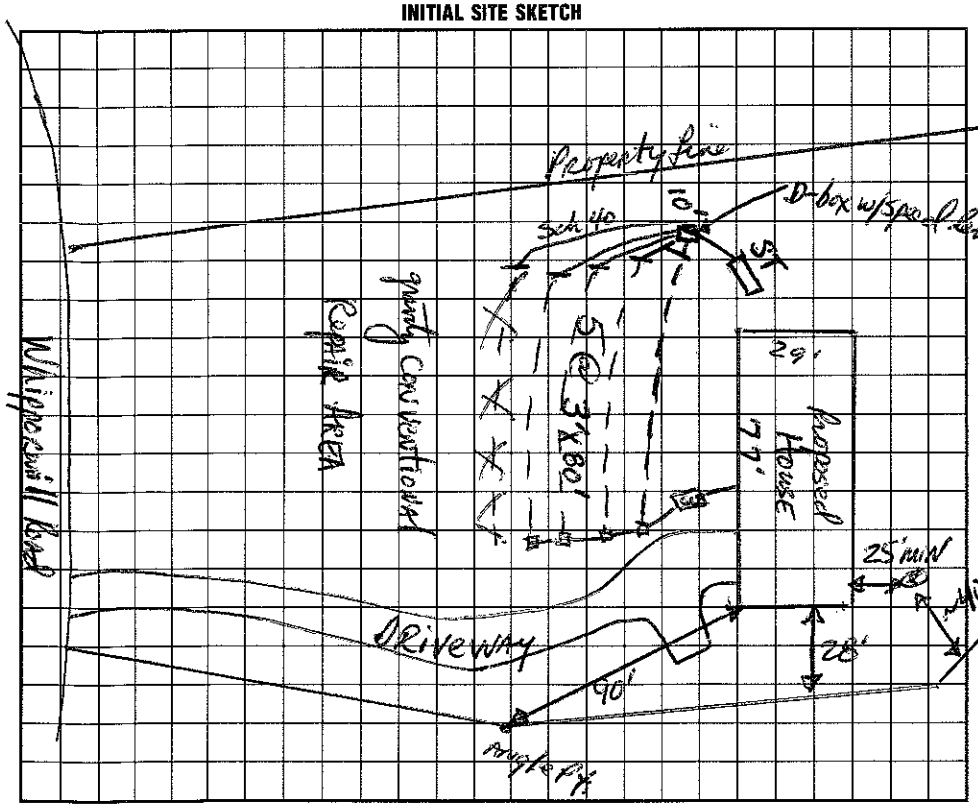

AS BUILT SKETCH

I understand that this permit can be suspended or revoked if any false information is supplied toward securing the permit/any unauthorized changes are made to the site/any unauthorized changes are made in the installation of the system. Improvement Permit is valid for 60 months from date of issuance.

Signed: [signature] 11-29-94

Improvement Permit by: [signature] IRS date 11/29/94

Existing System Inspection by: date

Installed by: Curt Dunning

Certificate of Completion by: Wesley Sparks R.S. date 6/16/95

Operation Permit by: date

HEALTH DEPT. COPY: WHITE INSPECTION COPY (FINAL): GREEN OWNER COPY (FINAL): YELLOW INSPECTION COPY (INITIAL): PINK OWNER COPY (INITIAL): GOLD