9.30

IREDELL COUNTY HEALTH DEPARTMENT

STATESVILLE 704-878-5305 MOORESVILLE 704-664-5281

IMPROVEMENT PERMIT / AUTHORIZATION TO CONSTRUCT / OPERATION PERMIT / EXISTING SYSTEM INSPECTION

PERMIT# 069737 PIN# 4637441200 DATE 6/2/98

OWNER OR CONTRACTOR ARTHUR BULAGLIO PHONE: Business Home 568-4777

ADDRESS 11210 WALKING HORSE LN CHARLOTTE NC 28215

LOCATION 150 W - JL DOOLEE RD - TR WHITEOAK HILL ½ MILE

SUBDIVISION CLOT BLOCK / SECTION 10 LOT 21 LOT AREA SITE CLASS. ES DESIGN FLOW 360 L.T.A.R. —

Septic Tank: 1000 Gallons; STB 764 Date 5/5/98
Pump Tank: Gallons; PT Date
Pump Make: Model Serial No.
Nitrification Field: No Fields 1 Square Feet ~~200~~ 400 Linear Feet 200
No Lines 3@67' Trench Width 24" Max Trench Bottom Depth 36" Gravel Depth NA

☑ New System ☐ Repair System Type: I, II, III, IV, V, VI
System Description: GRAVEL PANEL
Repair System Description:
Maintenance Agreement Required: ☐ Yes ☑ No


☑ House/Mod. Home No. Bedrooms 3
☐ Mobile Home No. Bathrooms 2
☐ Business No. Employees
☐ Other
☐ Slab ☑ Crawl Space ☐ Basement w/plumbing ☐ Basement wo/plumbing

Water Supply: ☑ Individual ☐ Public ☐ Community

Comments:/Conditions:

Comments:/Conditions:

INITIAL SITE SKETCH

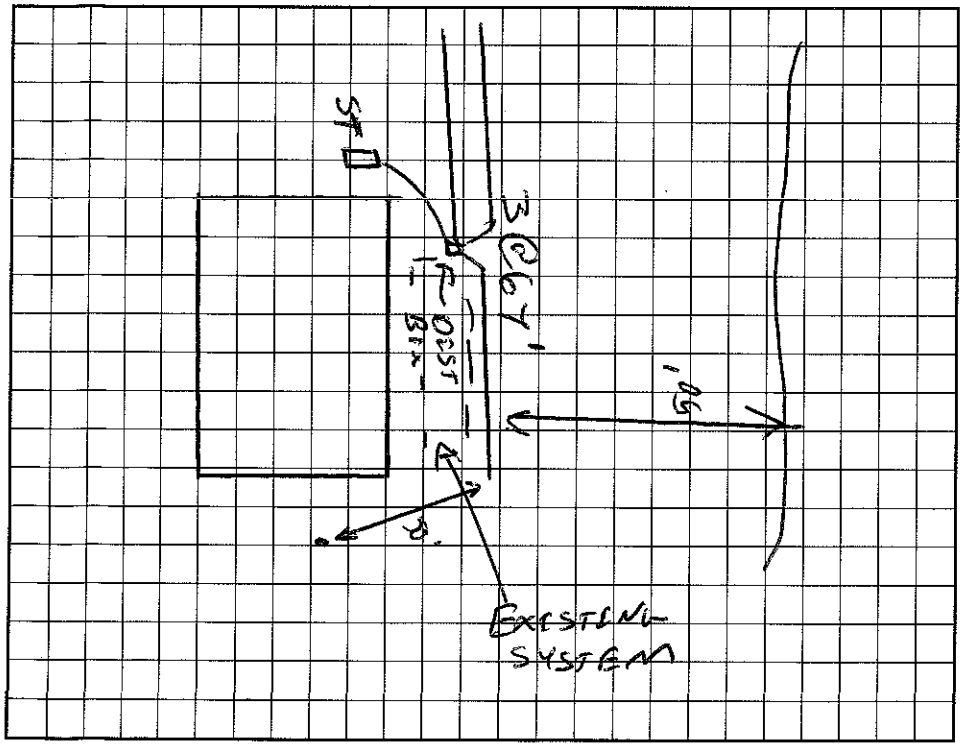

AS BUILT SKETCH

I understand that this permit can be suspended or revoked if any false information is supplied toward securing the permit/any unauthorized changes are made to the site/any unauthorized changes are made in the installation of the system. Improvement Permit with plat valid without expiration. Improvement Permit with site plan valid for sixty months. Authorization to Construct is valid for a period equal to that of Improvement Permit – not to exceed sixty months.

Signed: date

Improvement Permit by: C. [signature] RS date 6/2/98

Authorization to Construct by: C. [signature] RS date 6/2/98

Installed by: ORBISON

Operation Permit by: C. [signature] RS date 6/4/98

Existing System Inspection by: date

HEALTH DEPT. COPY: WHITE INSPECTION COPY (FINAL): GREEN OWNER COPY (FINAL): YELLOW INSPECTION COPY (INITIAL): PINK OWNER COPY (INITIAL): GOLD