IREDELL COUNTY HEALTH DEPARTMENT

Statesville Phone TR 3-7271 Mooresville Phone NO 3-1271

PERMIT TO INSTALL SEPTIC TANK

Permit No. _____ Permit Date 13 May 1966

Owner Art. Buraglio Address Chas. N.C.

Installed By Ostwalt Address Trautman


Location of Property Lot 21 Sect 10

Tank		Capacity		Length of Lines		Fixtures	
Block	(✓)	1000	(✓)	225'	(✓)	No. of Baths	( )
Precast	( )	1250	( )	250'	( )	Dishwasher	( )
		1500	( )	Other _____		Garbage Grdr.	( )
		Other _____				Other _____	

NOTIFY HEALTH DEPARTMENT AT LEAST EIGHT HOURS BEFORE TANK IS TO BE INSPECTED.

Final Inspection 13 May 1966 Approved (✓) Disapproved ( )

Remarks Lot 22 Lot 33' 12" Deep

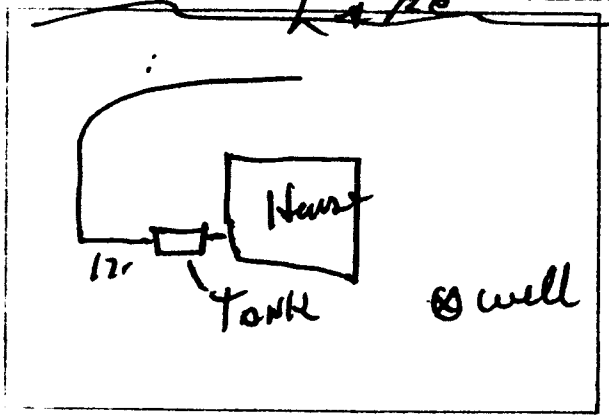

Sketch of Installation

Sanitarian