2 of

IREDELL COUNTY HEALTH DEPARTMENT

STATESVILLE 704-878-5305 MOORESVILLE 704-664-5281

IMPROVEMENT PERMIT / AUTHORIZATION TO CONSTRUCT / OPERATION PERMIT / EXISTING SYSTEM INSPECTION

PERMIT# 080513 PIN# 4639 44 1586 DATE 4/23/99

OWNER OR CONTRACTOR Steve Kinion PHONE: Business 664 - 1437 Home

ADDRESS 171 Mills Forest Lane Mooresville, NC. 28117

LOCATION 150 W TL Doolie Rd. TR Whippoorwill Rd. ~ .5 mile past Kingfisher on (R)

SUBDIVISION WHIPPORWILL WDS BLOCK / SECTION LOT 37 LOT AREA .79 SITE CLASS PS DESIGN FLOW 360 L.T.A.R. .3

Septic Tank: 1000 Gallons; STB 794 Date 1/19/02
Pump Tank: Gallons; PT Date
Pump Make: Model Serial No.
Nitrification Field: No Fields 1 Square Feet 1200 Linear Feet 400
No Lines ~~5 or 6~~ Trench Width 36" Max Trench Bottom Depth 36" Gravel Depth 12"

☒ New System ☐ Repair System Type: I, (II), III, IV, V, VI
System Description: Grav - Conventional
Repair System Description: Grav - PPBS
Maintenance Agreement Required: ☐ Yes ☒ No


☒ House/Mod. Home No. Bedrooms 3
☐ Mobile Home No. Bathrooms 2
☐ Business No. Employees
☐ Other
☐ Slab ☒ Crawl Space ☐ Basement w/plumbing ☐ Basement wo/plumbing

Water Supply: ☒ Individual ☐ Public ☐ Community


Comments:/Conditions: 4 @ 100' x 3'

Comments:/Conditions:

INITIAL SITE SKETCH (1"=40')

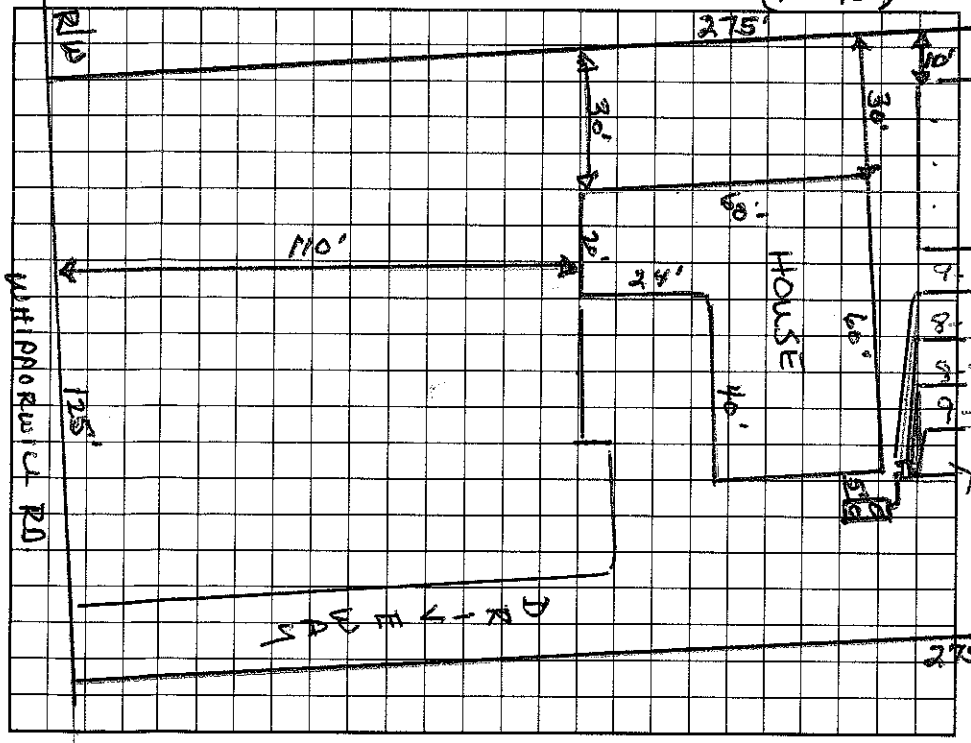

AS BUILT SKETCH

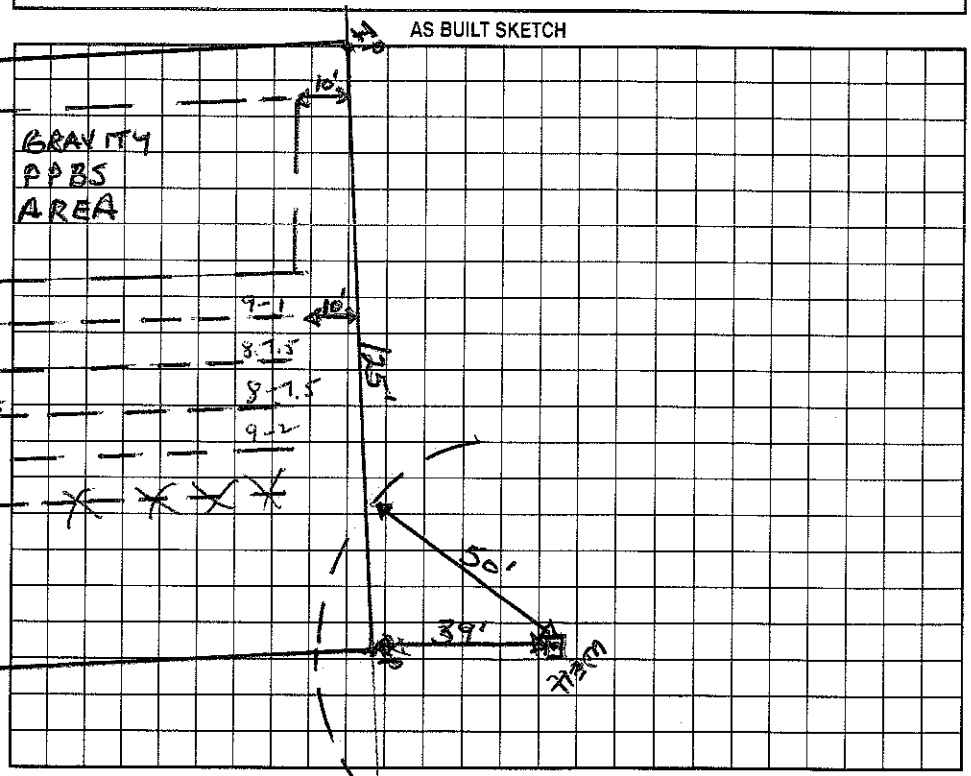

Permit can be suspended or revoked if any false information is supplied toward securing the permit/any unauthorized changes are made to the site/any unauthorized changes are made in the installation of the system. Improvement Permit with plat valid without expiration. Improvement Permit with site plan valid for sixty months. Authorization to Construct is valid for a period equal to that of Improvement Permit – not to exceed sixty months.

Signed: ✕ date

Improvement Permit by: Wesley Sparks RS. date 4/23/99

Authorization to Construct by: Wesley Sparks RS. date 4/23/99

Installed by: Roseman

Operation Permit by: Wesley Sparks RS. date 2/26/02

Existing System Inspection by: date

HEALTH DEPT. COPY: WHITE OWNER COPY (FINAL): YELLOW OWNER COPY (INITIAL): PINK