IREDELL COUNTY HEALTH DEPARTMENT

~~STATESVILLE 704-878-5305~~ MOORESVILLE 704-664-5281

IMPROVEMENT PERMIT / ~~CERTIFICATE OF COMPLETION~~ / OPERATION PERMIT / EXISTING SYSTEM INSPECTION

PROPERTY DESCRIPTION NO. 20216 DATE 3/9/95 TAX MAP NO. 2P 14A 33 Watershed: ☑ Yes ☐ No

OWNER OR CONTRACTOR ~~D.R. HOMES~~ STAN GOODMAN PHONE: Business 563-8711 Home

ADDRESS 6101 IDELWILD RD CHARLOTTE, NC

LOCATION 1.5 ON TL DOOLIE RD. TR WHIPPORWILL RD, PAST RD ON (R) TO NEXT LOT ON (R)

SUBDIVISION WHIPPORWILL BLOCK / SECTION LOT 33 LOT AREA > 1 AC SITE CLASS. P DESIGN FLOW 360 L.T.A.R. .35

Septic Tank: 1000 Gallons; STB 875 Date 11/18/98

Pump Tank: Gallons; PT Date

Pump Make: Model Serial No.

Nitrification Field: No Fields 1 Square Feet 1035 Linear Feet 345

No Lines 3 Trench Width 36" Max Trench Bottom Depth 32" Gravel Depth 12"

☑ New System ☐ Repair System Type: I, (II), III, IV, V, VI

System Description: GRAVITY - CONVENTIONAL

Repair System Description: SAME

Maintenance Agreement Required: ☐ Yes ☑ No

☐ House/Mod. Home ☐ Mobile Home ☐ Business ☐ Other

No. Bedrooms 3 No. Bathrooms 2.5 No. Employees


☐ Slab ☑ Crawl Space ☐ Basement w/plumbing ☐ Basement wo/plumbing

Water Supply: ☑ Individual ☐ Community ☐ Public


Comments: Use Crawl space - house shifted back on lot to avoid using pump on septic tank system. Lines must be on contour so depth can be maintained.

Comments:

INITIAL SITE SKETCH

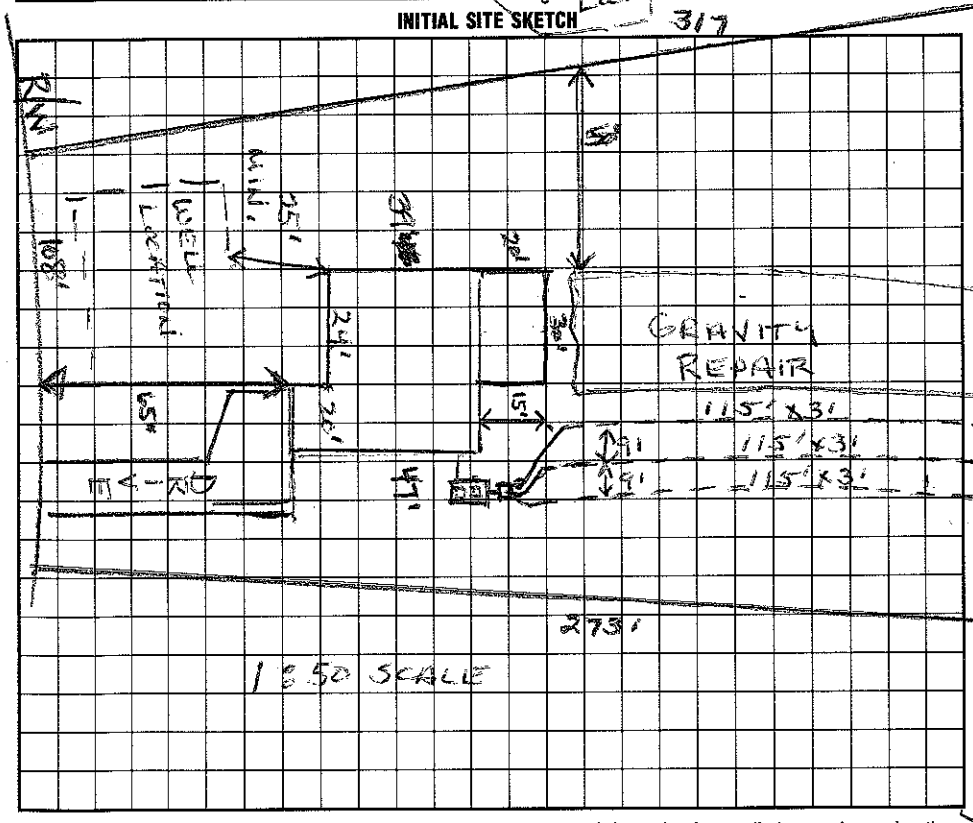

AS BUILT SKETCH

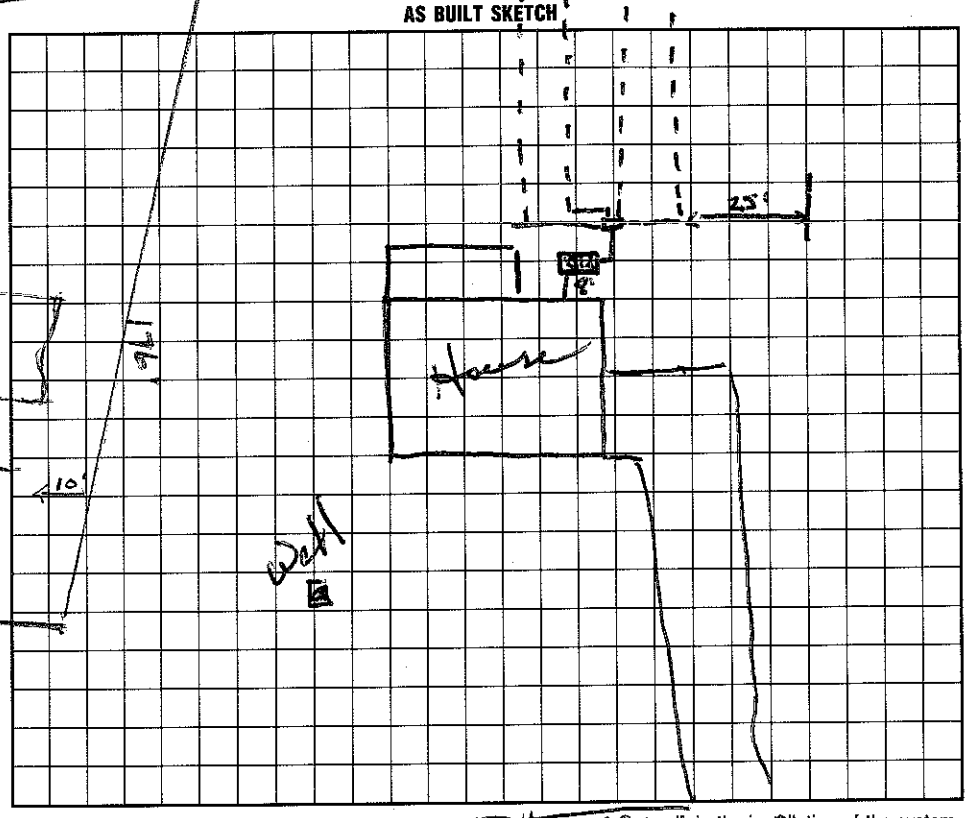

I understand that this permit can be suspended or revoked if any false information is supplied toward securing the permit/any unauthorized changes are made to the site/any unauthorized changes are made in the installation of the system. Improvement Permit is valid for 60 months from date of issuance.

Signed:

Improvement Permit by: Wesley Sparks RS date 3/9/95

Existing System Inspection by: Wesley Sparks RS date 5/20/95

Installed by: Wayne County

Certificate of Completion by: Wesley Sparks RS. date 5/12/98

Operation Permit by: Wesley Sparks RS. date 5/12/98

HEALTH DEPT. COPY: WHITE INSPECTION COPY (FINAL): GREEN OWNER COPY (FINAL): YELLOW INSPECTION COPY (INITIAL): PINK OWNER COPY (INITIAL): GOLD