IREDELL COUNTY HEALTH DEPARTMENT

STATESVILLE 704-878-5305 130.00 Paid MOORESVILLE 704-664-5281 11:30

IMPROVEMENT PERMIT / AUTHORIZATION TO CONSTRUCT / OPERATION PERMIT / EXISTING SYSTEM INSPECTION

PERMIT# 12561l PIN# 4637447529 DATE 1-6-05

OWNER OR CONTRACTOR Will Campagna / Medallion Prop. PHONE: Business 634-1185 Home

ADDRESS 308 Blume Rd Mooresville, NC 28117

LOCATION Highway 150 west TL Doolie TR Whippoorwill lot on left

SUBDIVISION C & T J BLOCK / SECTION 10 LOT 16 LOT AREA .67 Acre SITE CLASS PS DESIGN FLOW 480 gpd L.T.A.R. .3

Septic Tank: 1000 Gallons; STB 8/25 Date 3/4/05
Pump Tank: Gallons; PT Date
Pump Make: Model Serial No.
Nitrification Field: No Fields 1 Square Feet 540' Linear Feet 270'
No Lines 6@45 Trench Width 24" Max Trench Bottom Depth 30-36" Gravel Depth N/A

[X] New System [ ] Repair System Type: I, II, III, IV, V, VI
System Description: Gravity - Panel Block
Repair System Description: Lot Needed prior to 1983
Maintenance Agreement Required: [ ] Yes [X] No


[X] House/Mod. Home No. Bedrooms 4
[ ] Mobile Home No. Bathrooms
[ ] Business No. Employees
[ ] Other
[ ] Slab [ ] Crawl Space [X] Basement w/plumbing [ ] Basement wo/plumbing

Water Supply: [X] Individual [ ] Public [ ] Community


Comments:/Conditions: Keep Septic System at least 10' from PL, 50' from lake, 10' from house & 15' from future pool.

Comments:/Conditions: Note: Effluent goes to Flow Divider then to 2 separate Distribution boxes, feeding 3 lines each. Do Not use "Drop boxes"

INITIAL SITE SKETCH

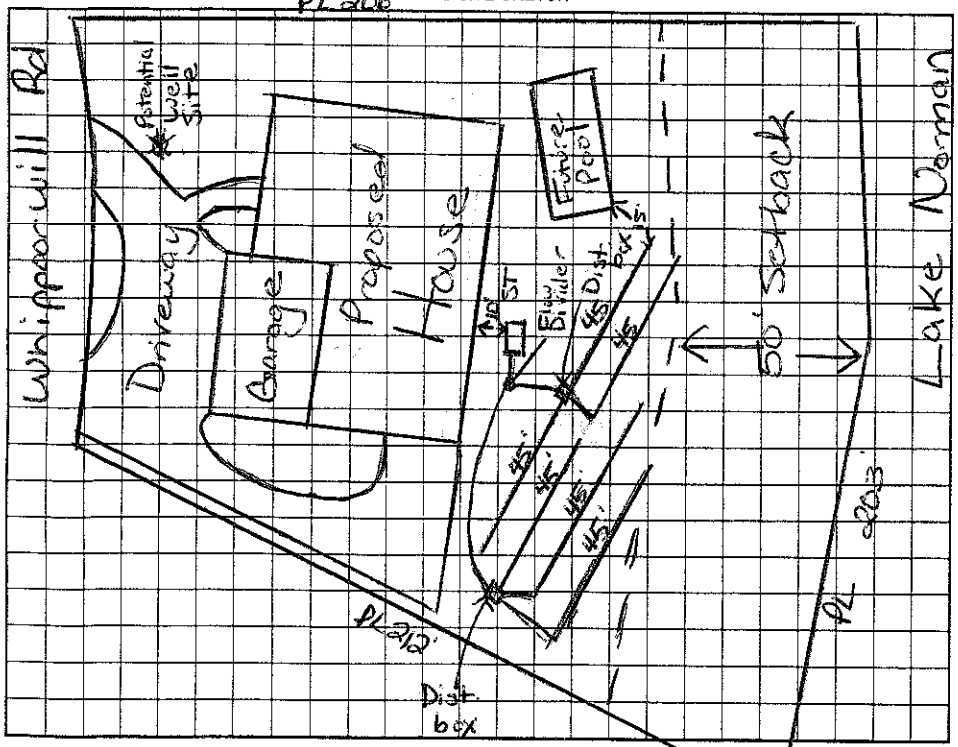

AS BUILT SKETCH

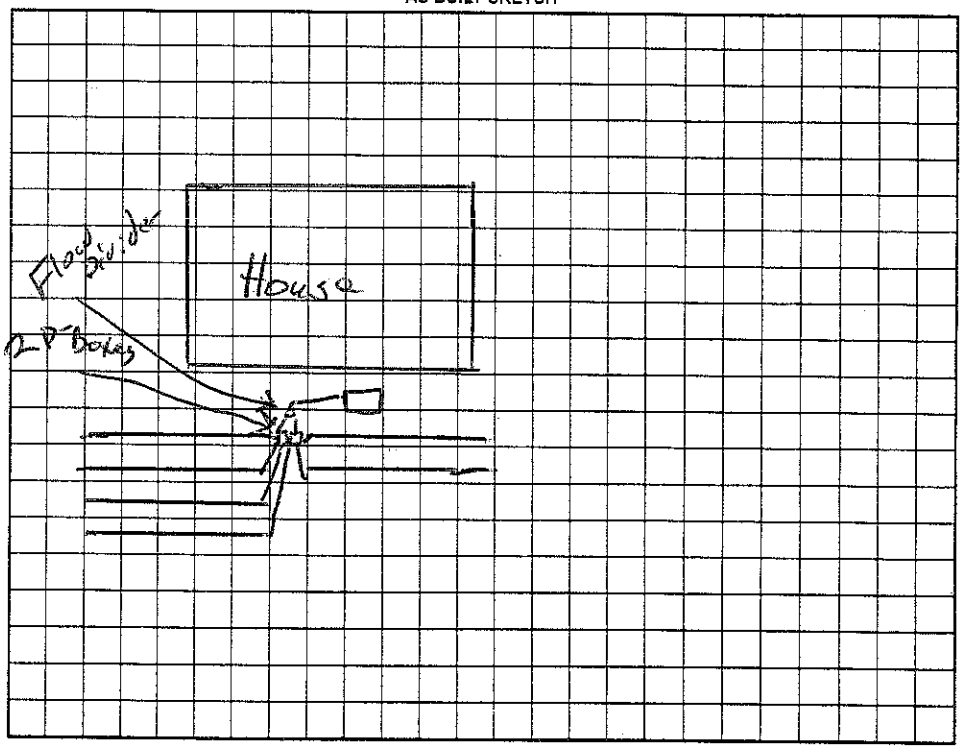

Permit can be suspended or revoked if any false information is supplied toward securing the permit/any unauthorized changes are made to the site/any unauthorized changes are made in the installation of the system. Improvement Permit with plat valid without expiration. Improvement Permit with site plan valid for sixty months. Authorization to Construct is valid for a period equal to that of Improvement Permit – not to exceed sixty months.

Signed: Will Campagna date 1/12/05
Improvement Permit by: Maintained Dotson RS date 1/6/05
Authorization to Construct by: Maintained Dotson RS date 1/6/05

Installed by: Rowan Septic
Operation Permit by: [signature] RS date 9/29/05
Existing System Inspection by: date

HEALTH DEPT. COPY: WHITE OWNER COPY (FINAL): YELLOW OWNER COPY (INITIAL): PINK