IREDELL COUNTY HEALTH DEPARTMENT

STATESVILLE 704-878-5305 280.00 Paid MOORESVILLE 704-664-5281

IMPROVEMENT PERMIT / AUTHORIZATION TO CONSTRUCT / OPERATION PERMIT / EXISTING SYSTEM INSPECTION

PERMIT# 10881620 PIN# 4637441910 DATE 10-10-2002

OWNER OR CONTRACTOR Stephen & Deborah Wise PHONE: Business 507-6641 Home 664-9473

ADDRESS 173 Whippoorwill Rd. Mooresville, NC 28117 Fax 658-1599

LOCATION Hwy 150 West TL Doolie TR Whippoorwill Rd on left #173

SUBDIVISION Cleat BLOCK / SECTION 10 LOT 14 LOT AREA ~1.0Acre SITE CLASS PS DESIGN FLOW 360gpd L.T.A.R. .3

Septic Tank: 1000 Gallons; STB 1007 Date 9/18/02
Pump Tank: ____ Gallons; PT ____ Date ____
Pump Make: ____ Model ____ Serial No. ____
Nitrification Field: No Fields 1 Square Feet 390' Linear Feet 130'
No Lines 2@65' Trench Width 36" Max Trench Bottom Depth 36"+ Gravel Depth N/A

[X] New System [ ] Repair System Type: I, II, III, IV, V, VI
System Description: Addition Gravity-25% Reduction
Repair System Description: Panel Block
Maintenance Agreement Required: [ ] Yes [X] No

[X] House/Mod. Home No. Bedrooms 3
[ ] Mobile Home No. Bathrooms 2
[ ] Business No. Employees ____
[ ] Other ____
[ ] Slab [X] Crawl Space [ ] Basement w/plumbing [ ] Basement wo/plumbing


Water Supply: [X] Individual [ ] Public [ ] Community

Add to Exist System

Comments:/Conditions: Upgrading Septic System From 2 Bedrooms to 3 Bedrooms. Abandon Old ST, & install New one. Install 2-65'x3' Drainlines (Plastic Chamber or EZ Flow)

Comments:/Conditions: Keep addition's foundation at least 5' From Septic System, leave 6' between trenches. Trenches may be a little deeper on one side

INITIAL SITE SKETCH

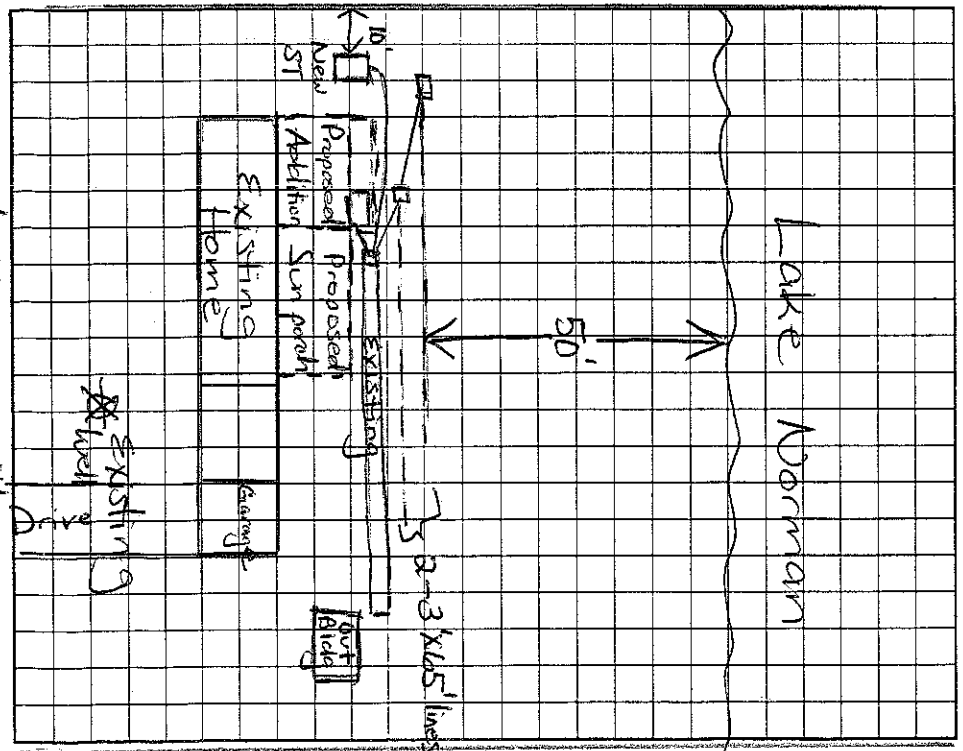

AS BUILT SKETCH

Use "Drop boxes" or Flow Divider between Old Drainfield & new drainlines.

Checked Drainlines 11/4/2002

Permit can be suspended or revoked if any false information is supplied toward securing the permit/any unauthorized changes are made to the site/any unauthorized changes are made in the installation of the system. Improvement Permit with plat valid without expiration. Improvement Permit with site plan valid for sixty months. Authorization to Construct is valid for a period equal to that of Improvement Permit – not to exceed sixty months.

Signed: Stephen D Wise date 10/11/02 Installed by: Wayne Gentry RS

Improvement Permit by: Maria H Dolan RS date 10/10/02 Operation Permit by: Maria H Dolan date 11/12/02

Authorization to Construct by: Maria H Dolan RS date 10/10/02 Existing System Inspection by: ____ date ____

HEALTH DEPT. COPY: WHITE OWNER COPY (FINAL): YELLOW OWNER COPY (INITIAL): PINK