IREDELL COUNTY HEALTH DEPARTMENT

STATESVILLE 704-878-5305 325.00 Paid Charles Abernethy 704 791-9[illegible] MOORESVILLE 704-664-5281

IMPROVEMENT PERMIT / AUTHORIZATION TO CONSTRUCT / OPERATION PERMIT / EXISTING SYSTEM INSPECTION

PERMIT# 10355 | PIN# 4637 45 0479 | DATE 11/28/01

OWNER OR CONTRACTOR Jamie Barrier | PHONE: Business | Home 704-309-9094

ADDRESS Po Box 291 Mooresville, NC. 28117

LOCATION 150 N To Doolie Rd, TR Whippoorwill TR Kingfisher, on (L) corner of Woodthrush Ln.

SUBDIVISION Whippoorwill Wds. | BLOCK / SECTION | LOT 29 | LOT AREA ~1.6Ac | SITE CLASS. AS | DESIGN FLOW 480 | L.T.A.R. .3

Septic Tank: 1000 Gallons; STB 1007 Date 5/2/02
Pump Tank: 1000 Gallons; PT 274 Date 4/11/02
Pump Make: | Model 560 Ams Serial No. 280 Ams
Nitrification Field: No Fields 1 Square Feet ~~480~~ Linear Feet ~~560~~
No Lines 4@70' Trench Width 2-3' Max Trench Bottom Depth 36" Gravel Depth No

[X] New System [ ] Repair System Type: I, II, III, (IV) V, VI
System Description: LP → 16" APBAS
Repair System Description: SAME
Maintenance Agreement Required: [X] Yes [ ] No


[X] House/Mod. Home No. Bedrooms 4
[ ] Mobile Home No. Bathrooms 3
[ ] Business No. Employees
[ ] Other
[ ] Slab [ ] Crawl Space [X] Basement w/plumbing [ ] Basement wo/plumbing

Water Supply: [X] Individual [ ] Public [ ] Community

Comments:/Conditions: 354


Comments:/Conditions:

INITIAL SITE SKETCH

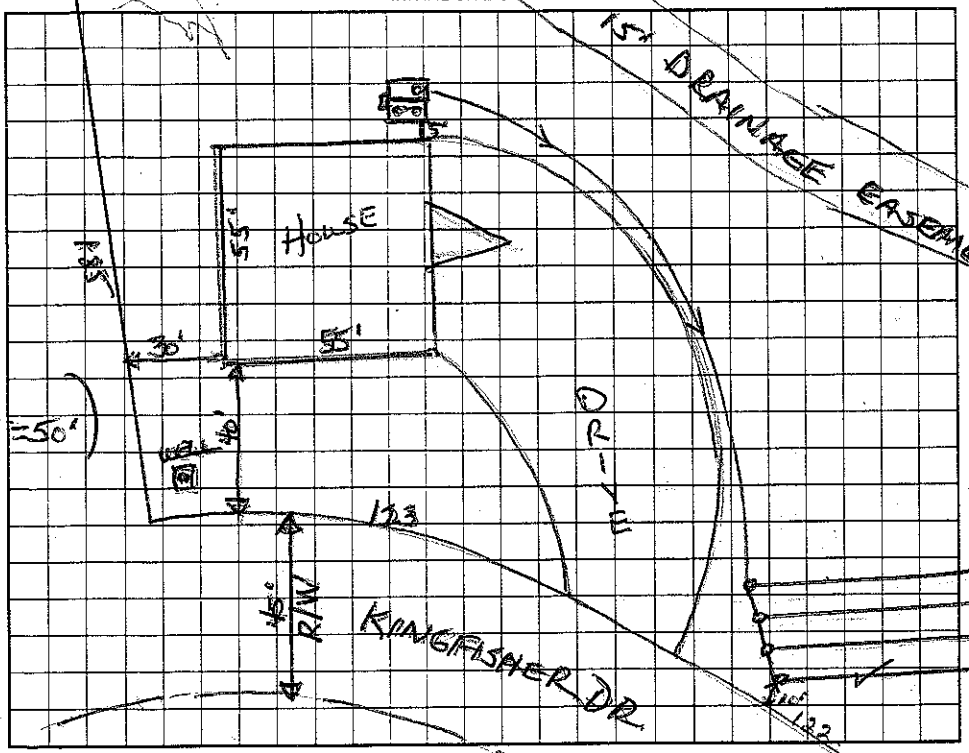

(1" = 50')

AS BUILT SKETCH

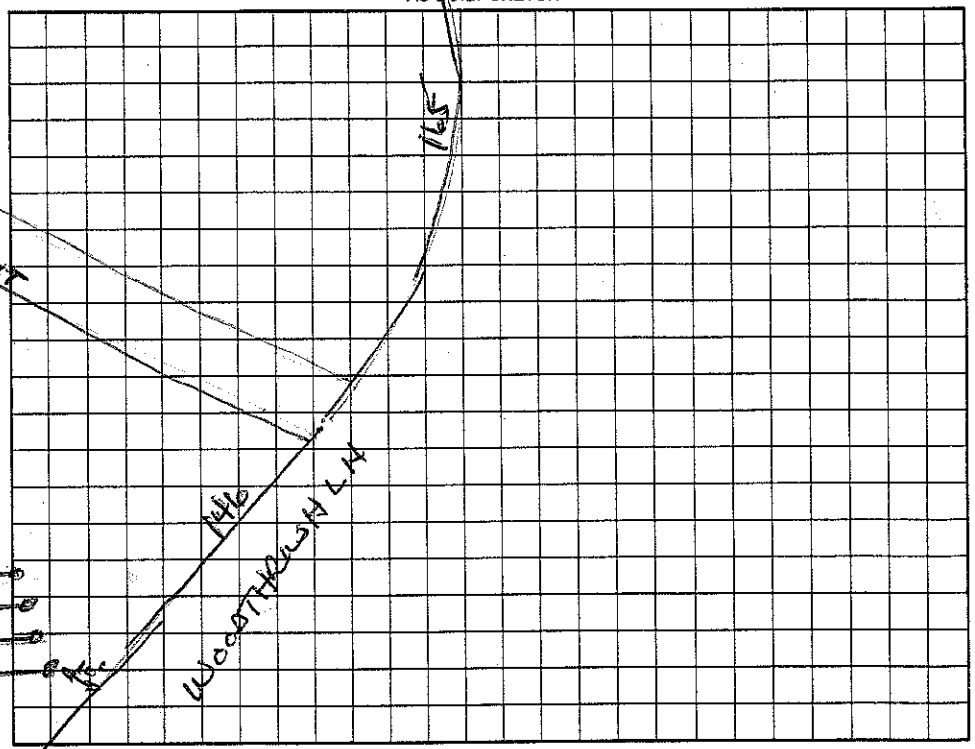

Permit can be suspended or revoked if any false information is supplied toward securing the permit/any unauthorized changes are made to the site/any unauthorized changes are made in the installation of the system. Improvement Permit with plat valid without expiration. Improvement Permit with site plan valid for sixty months. Authorization to Construct is valid for a period equal to that of Improvement Permit – not to exceed sixty months.

Signed: Melodie Barrier date 11-28-01
Improvement Permit by: Wesley Sparks R.S. date 11/28/01
Authorization to Construct by: Wesley Sparks RS date 11/28/01

Installed by: Shane Hill
Operation Permit by: Wesley Sparks R.S. date 7/29/02
Existing System Inspection by: date

HEALTH DEPT. COPY: WHITE OWNER COPY (FINAL): YELLOW OWNER COPY (INITIAL): PINK