IREDELL COUNTY HEALTH DEPARTMENT

STATESVILLE 704-878-5305 MOORESVILLE 704-664-5281

IMPROVEMENT PERMIT / CERTIFICATE OF COMPLETION / OPERATION PERMIT / EXISTING SYSTEM INSPECTION

PROPERTY DESCRIPTION NO. 17822 DATE March 14, 94 TAX MAP NO. 2P 14A 23 4637450877 Watershed: ☑ Yes ☐ No

OWNER OR CONTRACTOR Calvel Brothers PHONE: Business 478-2350 Home LN

ADDRESS PO Box 53, Stanleyville Road NC

LOCATION 150 W TR Dollie Rd. TR Whippoorwill TR Kingfisher TR Wood Thrush on Right

SUBDIVISION Whippoorwill Woods BLOCK / SECTION LOT 23 LOT AREA 1/2-3/4Ac SITE CLASS. PS DESIGN FLOW 360gpd L.T.A.R. .3

Septic Tank: 1000 Gallons; STB 901 C&G Date 4-25-94

Pump Tank: Gallons; PT Date

Pump Make: Model Serial No.

Nitrification Field: No Fields 1 Square Feet 1200 Linear Feet 400

No Lines 3 Trench Width 36" Max Trench Bottom Depth 36" Gravel Depth 12"

☑ New System ☐ Repair System Type: I, (II), III, IV, V, VI

System Description: gravity conventional

Repair System Description: same

Maintenance Agreement Required: ☐ Yes ☑ No

☑ House/Mod. Home No. Bedrooms 3

☐ Mobile Home No. Bathrooms 2

☐ Business No. Employees

☐ Other


☐ Slab ☑ Crawl Space ☐ Basement w/plumbing ☐ Basement wo/plumbing

Water Supply: ☑ Individual ☐ Community ☐ Public


Comments: 7/11/94 Ann OK to use drop boxes vs. single D-box OKH

Comments: Drop Boxes used

INITIAL SITE SKETCH

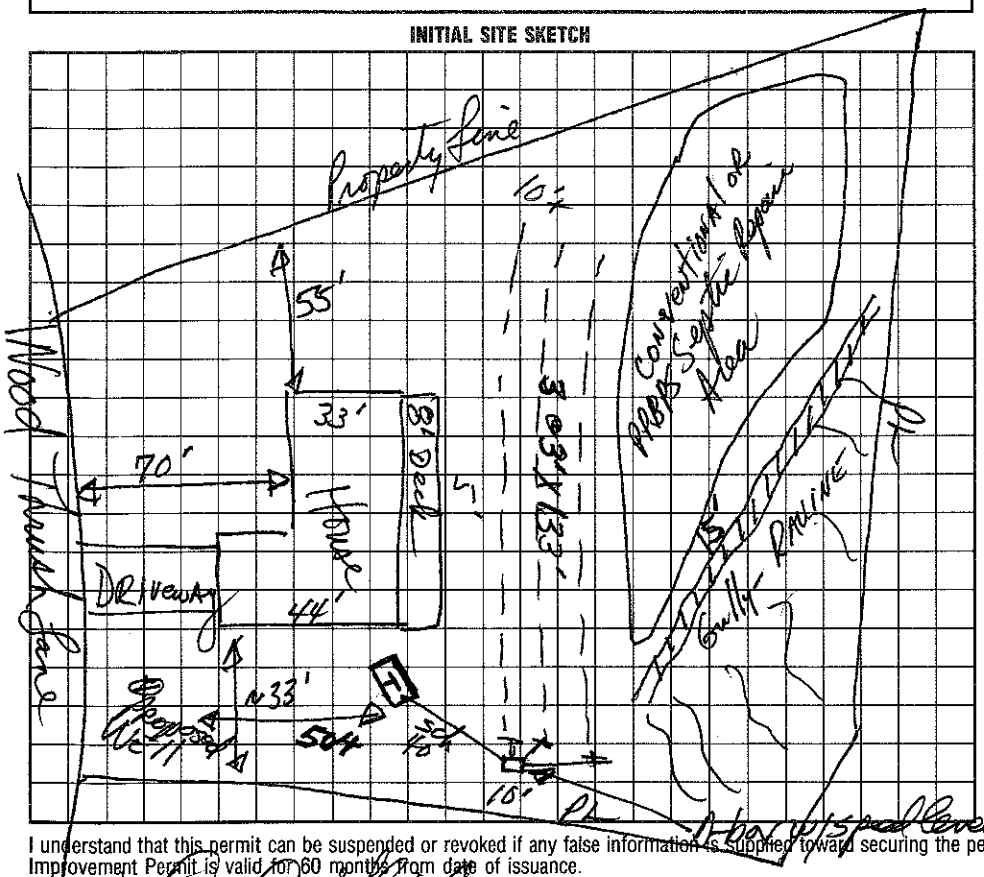

AS BUILT SKETCH

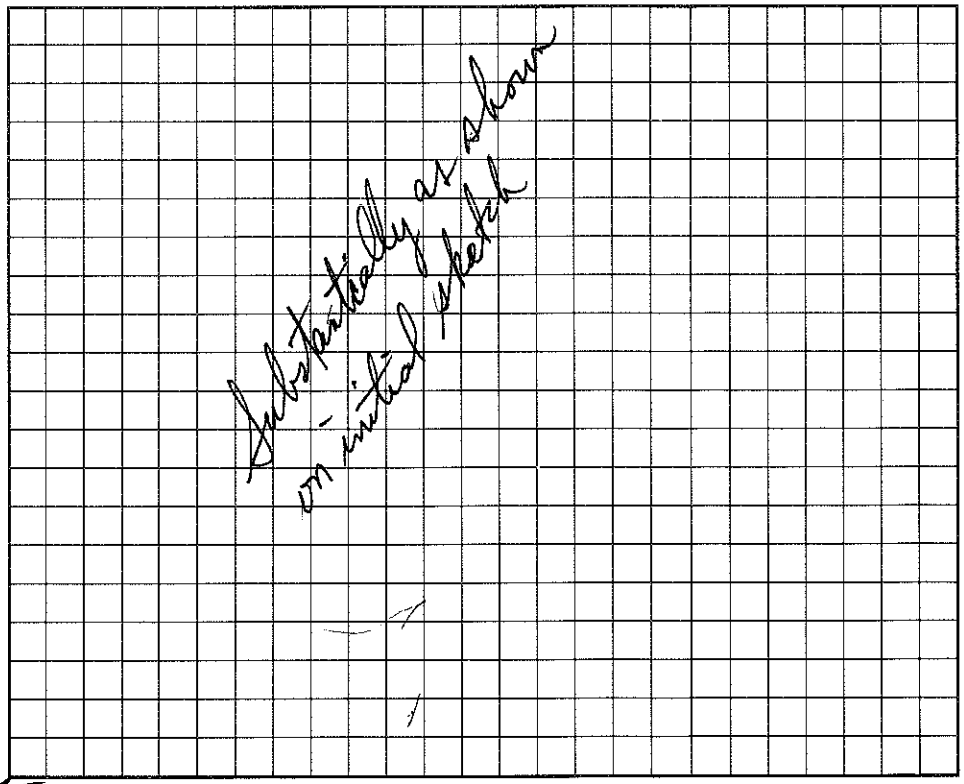

I understand that this permit can be suspended or revoked if any false information is supplied toward securing the permit/any unauthorized changes are made to the site/any unauthorized changes are made in the installation of the system. Improvement Permit is valid for 60 months from date of issuance.

Signed: [signature]

Improvement Permit by: James R Hinson, RS date 3/14/94

Existing System Inspection by: date

Installed by: Cline & Gilleland

Certificate of Completion by: James R Hinson, RS date 7/11/94

Operation Permit by: date

HEALTH DEPT. COPY: WHITE INSPECTION COPY (FINAL): GREEN OWNER COPY (FINAL): YELLOW INSPECTION COPY (INITIAL): PINK OWNER COPY (INITIAL): GOLD