1.45

IREDELL COUNTY HEALTH DEPARTMENT Const. Auth. STATESVILLE 704-878-5305 MOORESVILLE 704-664-5281

IMPROVEMENT PERMIT / ~~CERTIFICATE OF COMPLETION~~ / OPERATION PERMIT / EXISTING SYSTEM INSPECTION

PROPERTY DESCRIPTION NO. 20211 DATE Dec 11, 97 TAX MAP NO. 2P14A22 4637452842 Watershed: ☑ Yes ☐ No

OWNER OR CONTRACTOR Genesis Dev. / Jon Grigorian PHONE: Business _____ Home _____

ADDRESS PO Box 44, Sherrills Ford 386 Williamson Rd. Mooresville

LOCATION 150 W Dolie Rd. TR Whipporwill TR Kingfisher on left at jct w/ Woodthrush

SUBDIVISION Whipporwill Woods BLOCK / SECTION 1 LOT 22 LOT AREA ≥ 20,000 sf SITE CLASS. 2S DESIGN FLOW 480 gpd L.T.A.R. 0.35

Septic Tank: 1000 Gallons; STB 794 Date 9/11/97

Pump Tank: _____ Gallons; PT _____ Date _____

Pump Make: _____ Model _____ Serial No. _____

Nitrification Field: No. Fields 1 Square Feet 1035 Linear Feet 345

No. Lines 3@115' Trench Width 36" Max Trench Bottom Depth 30" Gravel Depth N/A

☑ New System ☐ Repair System Type: I, II, III, IV, V, VI

System Description: gravity Chambered/HWS/MOD

Repair System Description: 9 panel block

Maintenance Agreement Required: ☐ Yes ☑ No

☑ House/Mod. Home No. Bedrooms 4

☐ Mobile Home No. Bathrooms 2

☐ Business No. Employees _____

☐ Other _____

☐ Slab ☑ Crawl Space ☐ Basement w/plumbing ☐ Basement wo/plumbing


Water Supply: ☑ Individual ☐ Community ☐ Public

Comments: Modified Drainfield - 25% Reduction


Comments:

1" = 50'

INITIAL SITE SKETCH

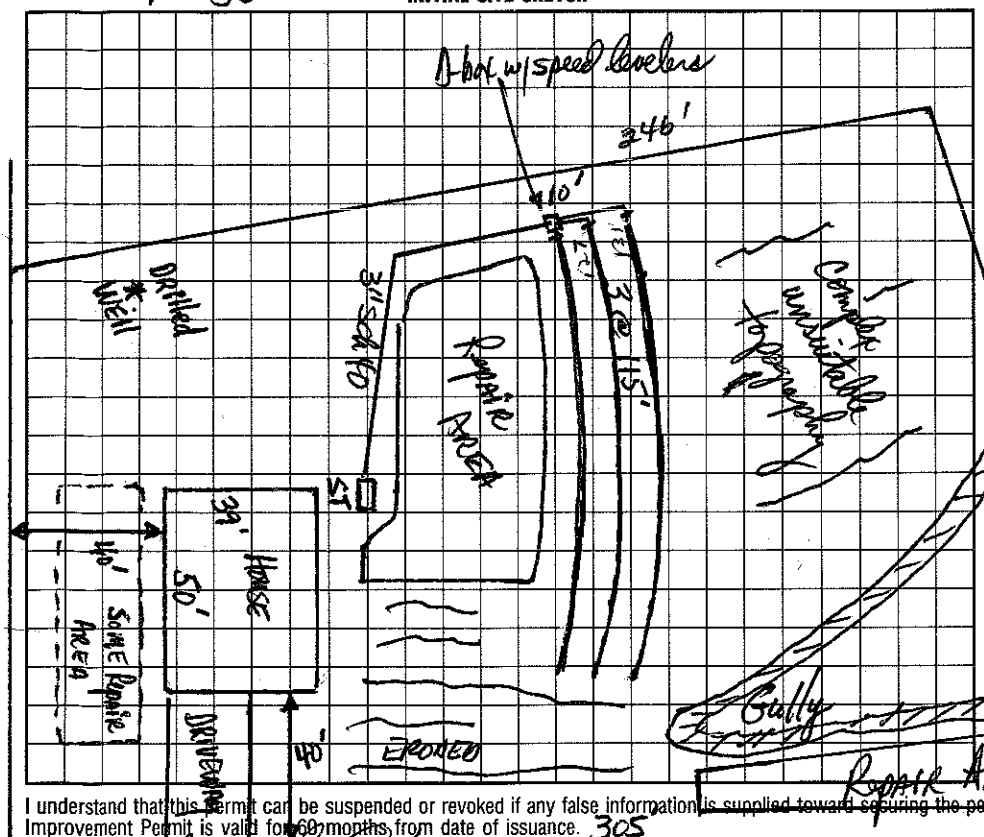

AS BUILT SKETCH

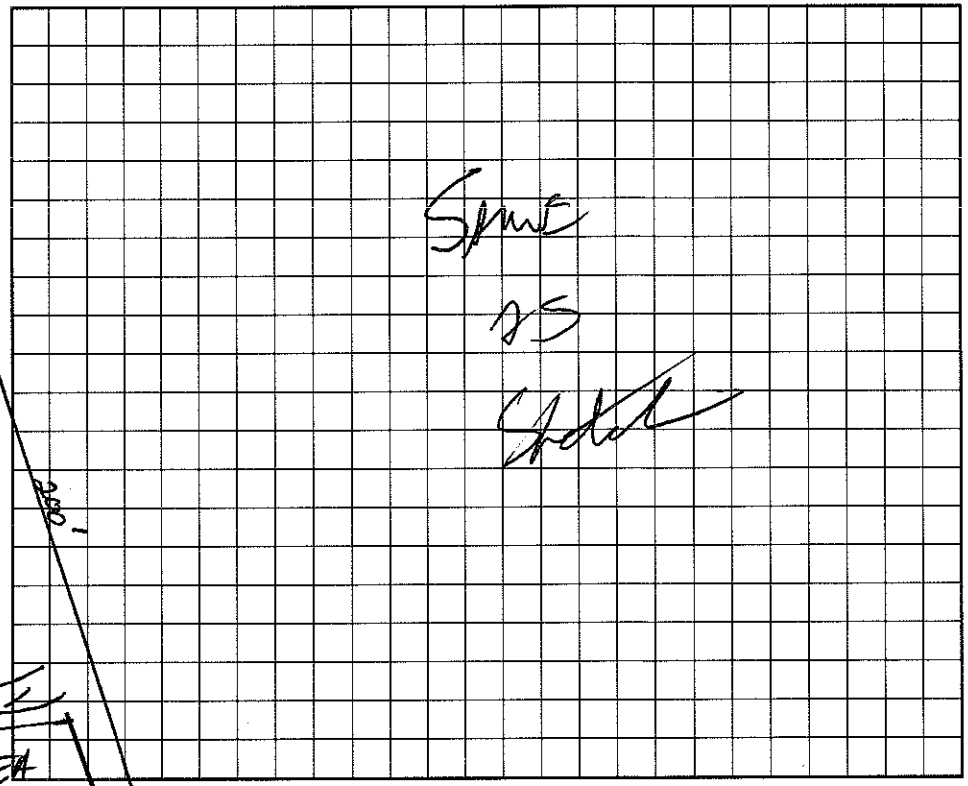

I understand that this permit can be suspended or revoked if any false information is supplied toward securing the permit/any unauthorized changes are made to the site/any unauthorized changes are made in the installation of the system. Improvement Permit is valid for 60 months from date of issuance. 305

Signed: _____

Improvement Permit by: _____ date 12-11-97

~~Existing System Inspection by:~~ _____ date 12-11-97

Construction Authorization

Installed by: DAVE CLARK

Certificate of Completion by: _____ date _____

Operation Permit by: _____ date 12/13/97

HEALTH DEPT. COPY: WHITE INSPECTION COPY (FINAL): GREEN OWNER COPY (FINAL): YELLOW INSPECTION COPY (INITIAL): PINK OWNER COPY (INITIAL): GOLD