73515

IREDELL COUNTY HEALTH DEPARTMENT

STATESVILLE 704-878-5305 MOORESVILLE 704-664-5281

IMPROVEMENT PERMIT / CERTIFICATE OF COMPLETION / OPERATION PERMIT / EXISTING SYSTEM INSPECTION

PROPERTY DESCRIPTION NO. 18928 DATE Aug. 29, '94 TAX MAP NO. 2P14A 10 4637453470 Watershed: ☑ Yes ☐ No

OWNER OR CONTRACTOR Paul Culotta PHONE: Business _____ Home L.N.

ADDRESS c/o Lakeshore Realty 386 Williamson Rd. Mooresville

LOCATION 150 W Ty Cobb Rd. TR Whippoorwill TR Kingfisher ~250-300' on Right

SUBDIVISION Whippoorwill Woods BLOCK / SECTION _____ LOT 10 LOT AREA .84ac SITE CLASS I Spec 1953 DESIGN FLOW 360 gpd L.T.A.R. .3

Septic Tank: 1000 Gallons; STB 794 Date 5/16/98

Pump Tank: _____ Gallons; PT _____ Date _____

Pump Make: _____ Model _____ Serial No. _____

Nitrification Field: No Fields 1 Square Feet _____ Linear Feet 200

No Lines 4-5 Trench Width 24" Max Trench Bottom Depth 36" Gravel Depth N/A

☑ New System ☐ Repair System Type: I, II, III, IV, V, VI

System Description: Gravity PVC SPS

Repair System Description: _____ SAME

Maintenance Agreement Required: ☐ Yes ☑ No

☑ House/Mod. Home No. Bedrooms 3

☐ Mobile Home No. Bathrooms 2

☐ Business No. Employees _____

☐ Other _____


☐ Slab ☑ Crawl Space ☐ Basement w/plumbing ☐ Basement wo/plumbing

Water Supply: ☑ Individual ☐ Community ☐ Public

Comments: Follow contour w/ laterals

Comments:

INITIAL SITE SKETCH

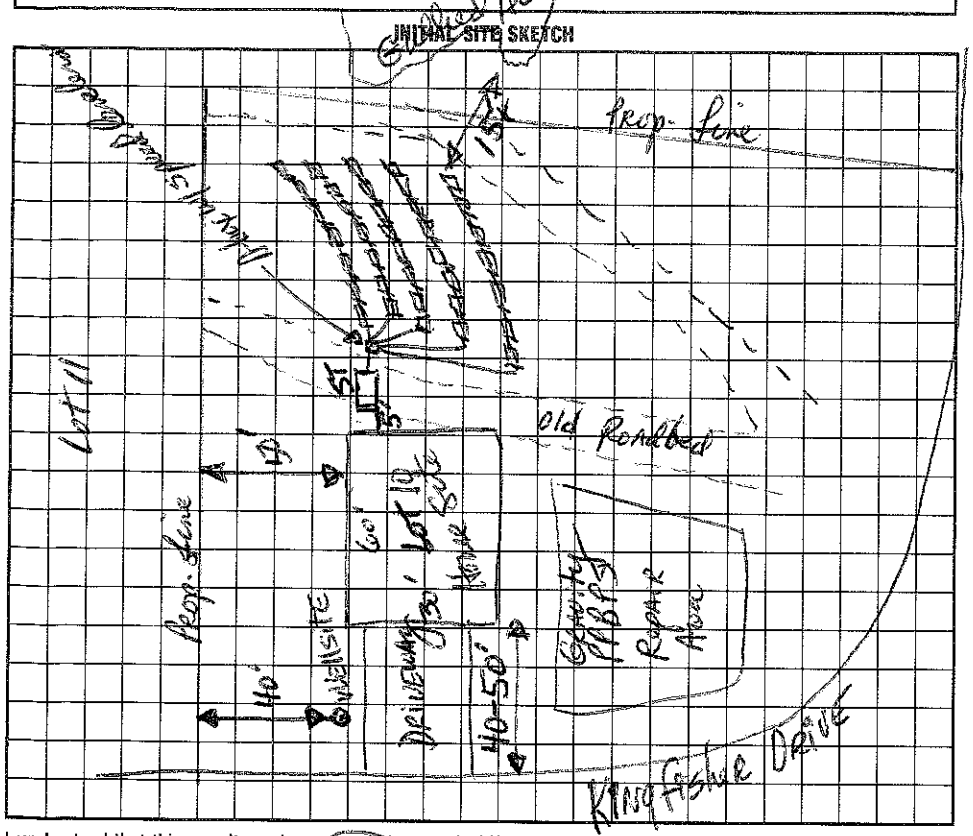

AS BUILT SKETCH

I understand that this permit can be suspended or revoked if any false information is supplied toward securing the permit/any unauthorized changes are made to the site/any unauthorized changes are made in the installation of the system. Improvement Permit is valid for 60 months from date of issuance.

Signed: _____

Improvement Permit by: _____ date 8/29/94

Existing System Inspection by: _____ date _____

Installed by: Reade Eudy

Certificate of Completion by: Wesley Sparks R.S. date 8/21/98

Operation Permit by: Wesley Sparks R.S. date 8/21/98

HEALTH DEPT. COPY: WHITE INSPECTION COPY (FINAL): GREEN OWNER COPY (FINAL): YELLOW INSPECTION COPY (INITIAL): PINK OWNER COPY (INITIAL): GOLD