IREDELL COUNTY HEALTH DEPARTMENT

STATESVILLE 704-878-5305 MOORESVILLE 704-664-5281

IMPROVEMENT PERMIT / CERTIFICATE OF COMPLETION / OPERATION PERMIT / EXISTING SYSTEM INSPECTIO

PROPERTY DESCRIPTION NO. 18258 DATE July 7, '94 TAX MAP NO. 2714A14 4637455971 Watershed: ☑ Yes ☐ L.N.

OWNER OR CONTRACTOR Jon Grigorian PHONE: Business _____ Home _____

ADDRESS _____

LOCATION 150 W. TR Doolie Rd. TR Whippoorwill TR Kingfisher on Right

SUBDIVISION Whippoorwill Woods BLOCK / SECTION _____ LOT 14 LOT AREA ±1.12 ac SITE CLASS. FS pr. 1956 DESIGN FLOW 360 gpd L.T.A.R. ≤ 3

Septic Tank: 1000 Gallons; STB 1012 Taylorsville Date 6-16-94

Pump Tank: _____ Gallons; PT _____ Date _____

Pump Make: _____ Model _____ Serial No. _____

Nitrification Field: No Fields 1 Square Feet 1200 Linear Feet 400

No Lines 4 Trench Width 36" Max Trench Bottom Depth 36" Gravel Depth 12"

☑ New System ☐ Repair System Type: I, II, III, IV, V, VI

System Description: gravity Conventional

Repair System Description: Gravity PPBS

Maintenance Agreement Required: ☐ Yes ☑ No

☑ House/Mod. Home No. Bedrooms 3

☐ Mobile Home No. Bathrooms 2

☐ Business No. Employees _____

☐ Other _____


☐ Slab ☑ Crawl Space ☐ Basement w/plumbing ☐ Basement wo/plumbing

Water Supply: ☑ Individual ☐ Community ☐ Public


Comments:

Comments: Dam installed in lowest trench ~ 3/4 way due to excessive trench bottom grade.

INITIAL SITE SKETCH

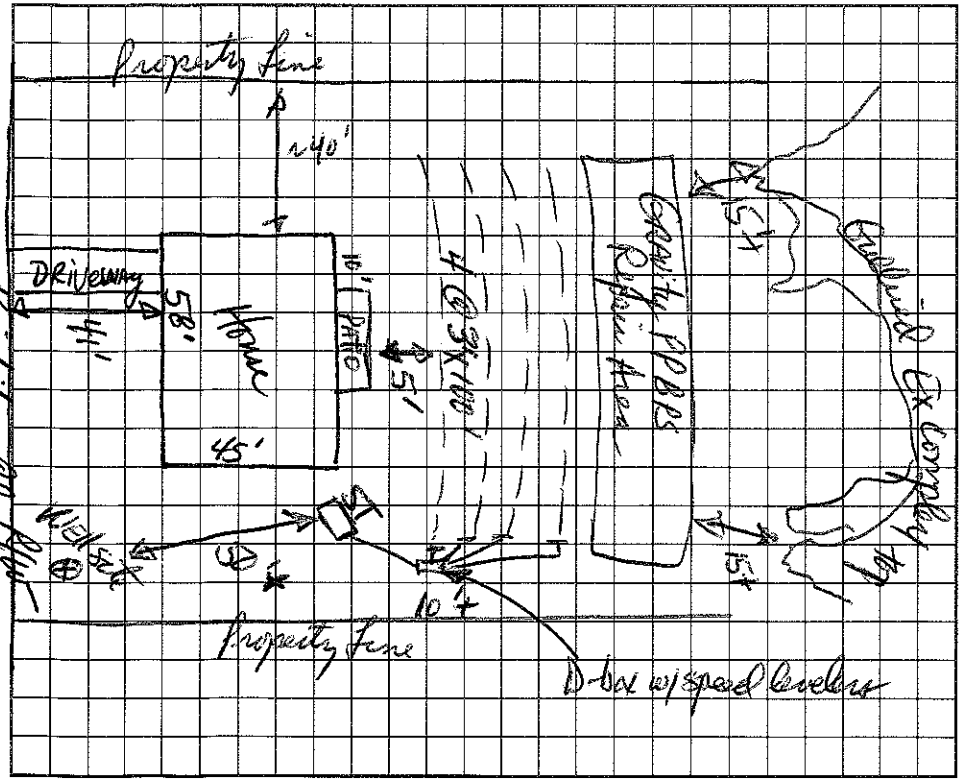

AS BUILT SKETCH

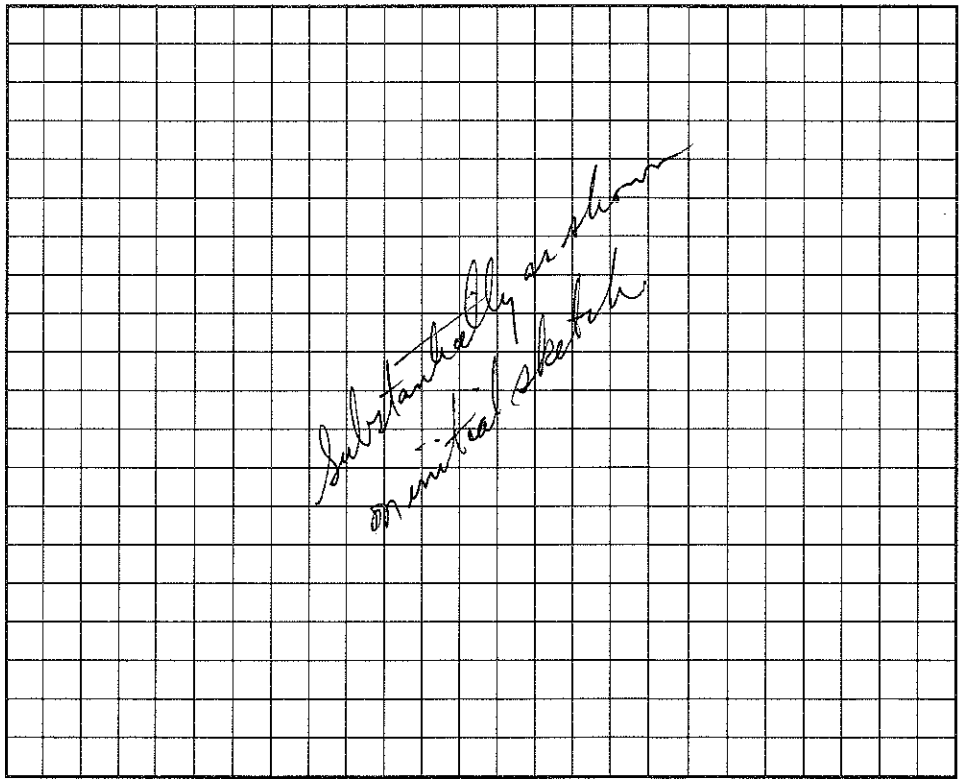

I understand that this permit can be suspended or revoked if any false information is supplied toward securing the permit/any unauthorized changes are made to the site/any unauthorized changes are made in the installation of the system. Improvement Permit is valid for 60 months from date of issuance.

Signed: _____

Improvement Permit by: Jon Grigorian Jerry R. Hinson, RS date 7/7/94

Existing System Inspection by: _____ date _____

Installed by: Kenny Pearson

Certificate of Completion by: Jerry R. Hinson, RS date 9-15-94

Operation Permit by: _____ date _____

HEALTH DEPT. COPY: WHITE INSPECTION COPY (FINAL): GREEN OWNER COPY (FINAL): YELLOW INSPECTION COPY (INITIAL): PINK OWNER COPY (INITIAL): GOLD