4637-46-3007

IREDELL COUNTY HEALTH DEPARTMENT

STATESVILLE 704-878-5305 MOORESVILLE 704-664-5281

IMPROVEMENT PERMIT / CERTIFICATE OF COMPLETION / OPERATION PERMIT / EXISTING SYSTEM INSPECTION

PROPERTY DESCRIPTION NO. @ 19030 DATE June 29, '94 TAX MAP NO. 2P14A20 Watershed: ☑ Yes ☐ No

OWNER OR CONTRACTOR Jon Grosjean PHONE: Business 664-3400 Home

ADDRESS Rt 7 Box 709, Mooresville LOT

LOCATION 150 W to Poplin Rd TR Whippoorwill TR Kingfisher on left mean Cul-de-Sac

SUBDIVISION Whippoorwill Woods BLOCK / SECTION LOT 30 LOT AREA 110'x213' SITE CLASS. PE pg. 194 DESIGN FLOW 360 gpd L.T.A.R. .3

Septic Tank: 1000 Gallons; STB 10 12 Tp Date 7-8-94

Pump Tank: Gallons; PT Date

Pump Make: Model Serial No.

Nitrification Field: No Fields 2 Square Feet Linear Feet 200

No Lines 4+3 Trench Width 24" Max Trench Bottom Depth 36" Gravel Depth NA

☑ New System ☐ Repair System Type: I, II, (III) IV, V, VI

System Description: gravity PPBPS

Repair System Description: pumped cap on PPBPS

Maintenance Agreement Required: ☐ Yes ☑ No

☑ House/Mod. Home No. Bedrooms 3

☐ Mobile Home No. Bathrooms 2

☐ Business No. Employees

☐ Other


☐ Slab ☑ Crawl Space ☐ Basement w/plumbing ☐ Basement wo/plumbing

Water Supply: ☑ Individual ☐ Community ☐ Public


Comments: Install 100' of each subfield, follow contour w/ laterals; if able to get system in less # trenches than shown (ex 3+2) then this will be OK

Comments: Upper subfield installed in 3 ditches, lower subfield in 2 ditches. Provide adequate surface drainage condition w/ final landscaping

INITIAL SITE SKETCH

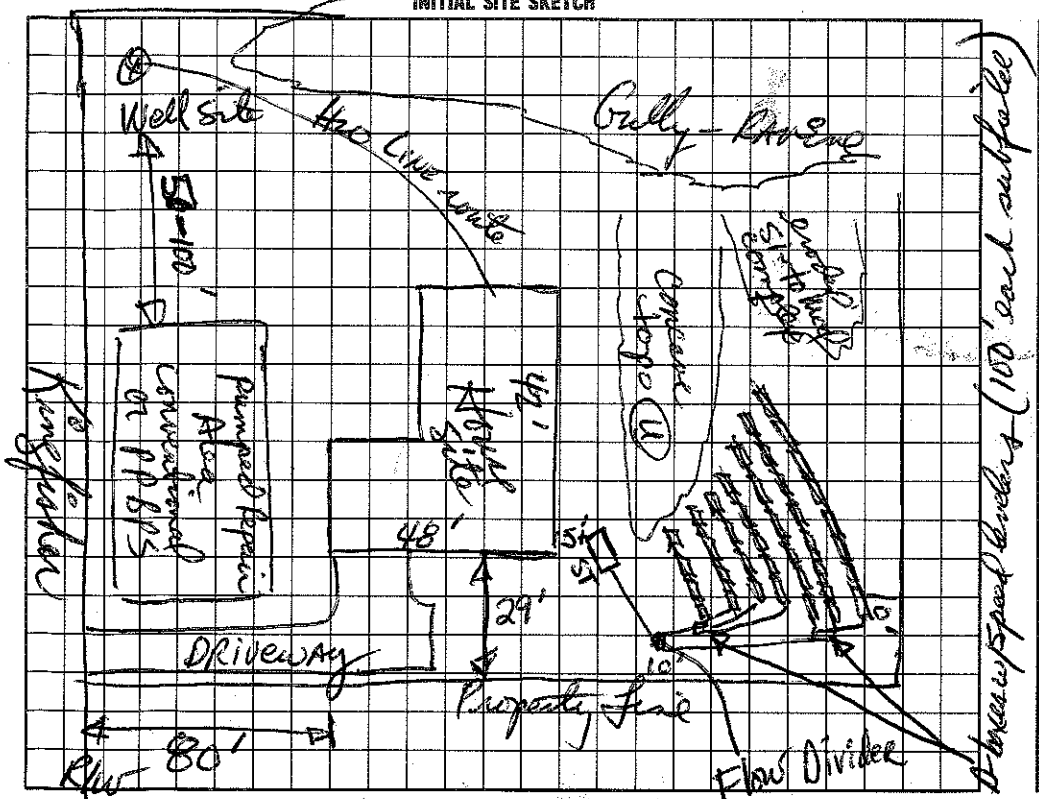

AS-BUILT SKETCH

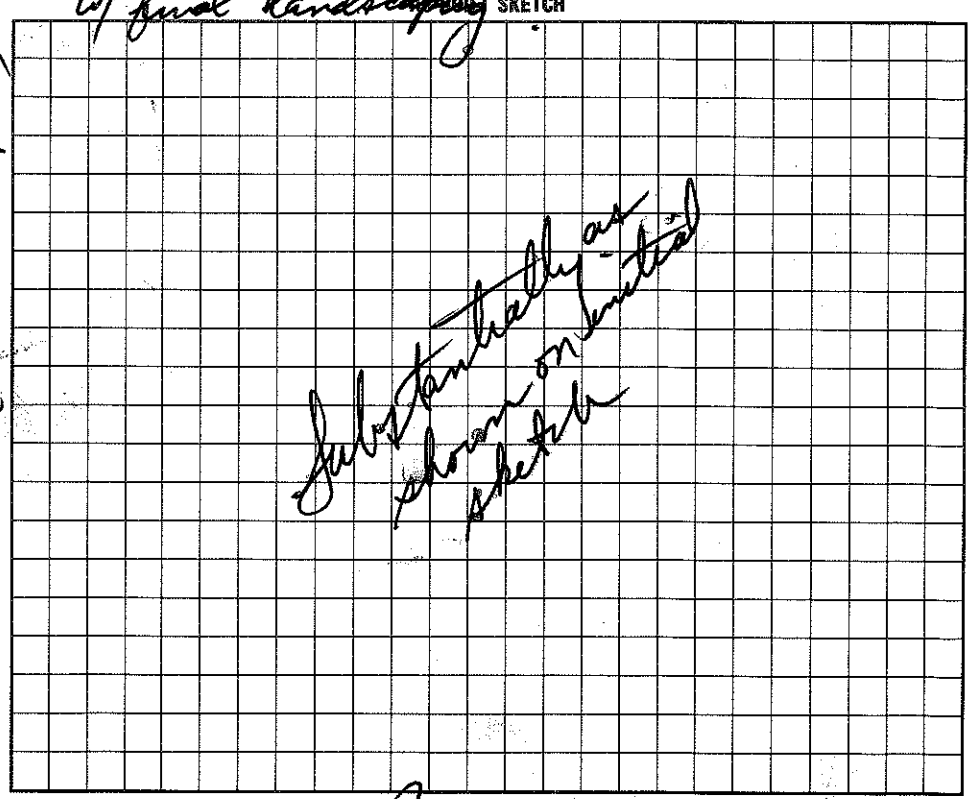

I understand that this permit can be suspended or revoked if any false information is supplied toward securing the permit/any unauthorized changes are made to the site/any unauthorized changes are made in the installation of the system. Improvement Permit is valid for 60 months from date of issuance.

Signed: Bill Ball

Improvement Permit by: Jerrell R. Hanson IRS date 6/29/94

Existing System Inspection by: date

Installed by: Kenny Pearson

Certificate of Completion by:

Operation Permit by: James R. Hanson IRS date 9-27-94

HEALTH DEPT. COPY: WHITE INSPECTION COPY (FINAL): GREEN OWNER COPY (FINAL): YELLOW INSPECTION COPY (INITIAL): PINK OWNER COPY (INITIAL): GOLD