4637463202

IREDELL COUNTY HEALTH DEPARTMENT

STATESVILLE 704-878-5305 MOORESVILLE 704-664-5281

IMPROVEMENT PERMIT / CERTIFICATE OF COMPLETION / OPERATION PERMIT / EXISTING SYSTEM INSPECTION

PROPERTY DESCRIPTION NO. 20729 DATE 4/4/95 TAX MAP NO. 2P 14 A 19 Watershed: ☐ Yes ☒ No

OWNER OR CONTRACTOR JON GREGORIAN PHONE: Business 664-3400 Home

ADDRESS ~~5460~~ 386 WILLIAMSON RD. MRSVL 28115

LOCATION 150 N TL ADOLIE RD TR WHIPPORWILL TR KINGFISHER TO CUL DE SAC, ⓒ OF CENTER Ⓛ

SUBDIVISION WHIPPORWILL WOODS BLOCK / SECTION I LOT 19 LOT AREA .81 AC SITE CLASS. P DESIGN FLOW 360 L.T.A.R. .3 - .35

Septic Tank: 1000 Gallons; STB 794 Date 9/17/97

Pump Tank: _____ Gallons; PT _____ Date _____

Pump Make: _____ Model _____ Serial No. _____

Nitrification Field: No Fields 1 Square Feet 1200 Linear Feet 400

No Lines 4 Trench Width 36" Max Trench Bottom Depth 30-32" Gravel Depth _____

☒ New System ☐ Repair System Type: I, Ⓘ, III, IV, V, VI

System Description: CONV - DIST BOX

Repair System Description: SAME

Maintenance Agreement Required: ☐ Yes ☒ No

☒ House/Mod. Home No. Bedrooms 3

☐ Mobile Home No. Bathrooms 2

☐ Business No. Employees _____

☐ Other _____


☐ Slab ☒ Crawl Space ☐ Basement w/plumbing ☐ Basement wo/plumbing

Water Supply: ☒ Individual ☐ Community ☐ Public

Comments:

Comments:

INITIAL SITE SKETCH

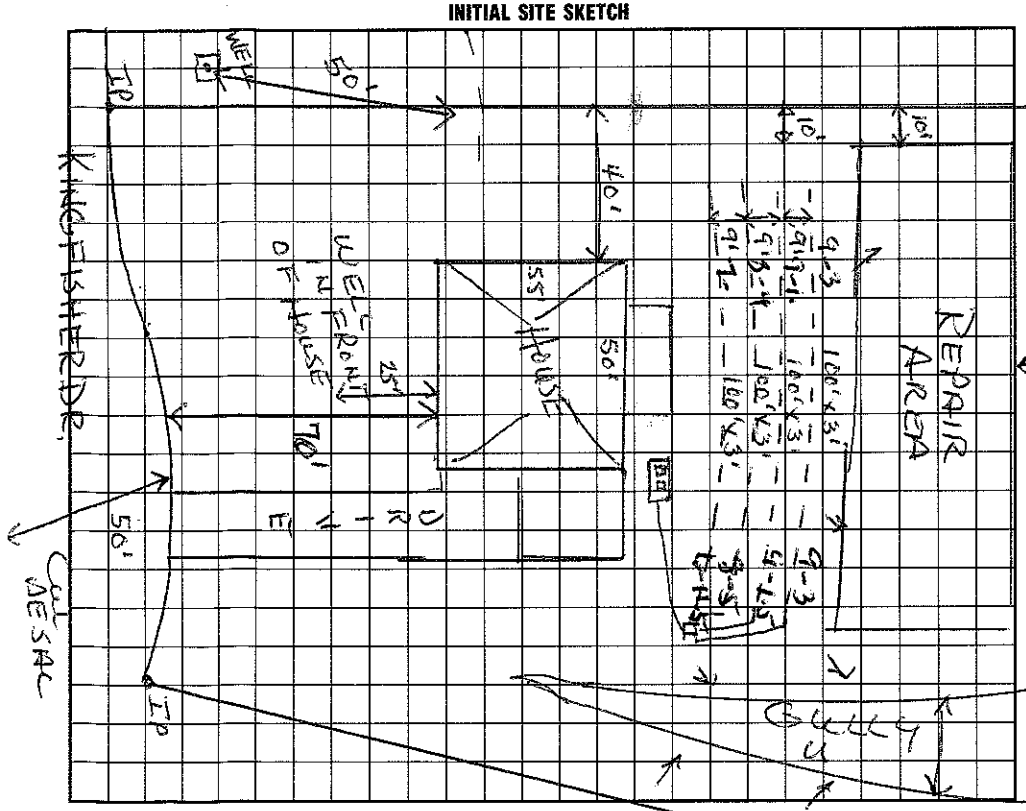

AS BUILT SKETCH

I understand that this permit can be suspended or revoked if any false information is supplied toward securing the permit/any unauthorized changes are made to the site/any unauthorized changes are made in the installation of the system. Improvement Permit is valid for 60 months from date of issuance.

Signed: _____

Improvement Permit by: Wesley Sparks RS. date 4/4/95

Existing System Inspection by: _____ date _____

Installed by: Dana Clark

Certificate of Completion by: Wesley Sparks RS. date 12/16/97

Operation Permit by: Wesley Sparks RS date 12/16/97

HEALTH DEPT. COPY: WHITE INSPECTION COPY (FINAL): GREEN OWNER COPY (FINAL): YELLOW INSPECTION COPY (INITIAL): PINK OWNER COPY (INITIAL): GOLD