IREDELL COUNTY HEALTH DEPARTMENT

Authority to Construct

STATESVILLE 704-878-5305 MOORESVILLE 704-664-5281

IMPROVEMENT PERMIT / CERTIFICATE OF COMPLETION / OPERATION PERMIT / EXISTING SYSTEM INSPECTION

PROPERTY DESCRIPTION NO. 17544 DATE March 27, 95 TAX MAP NO. 2P14A18 4637464304 Watershed: ☑ Yes ☐ No WSIV

OWNER OR CONTRACTOR Ken & Francis Robinson PHONE: Business _____ Home _____

ADDRESS _____

LOCATION 150 W Ty Pacific Rd TR Whippoorwill TR Kingfisher at end

SUBDIVISION Whippoorwill Woods BLOCK / SECTION _____ LOT 18 LOT AREA 1.023 ac SITE CLASS. B per 1996 DESIGN FLOW 360 gpd L.T.A.R. 1.3

Septic Tank: 1000 Gallons; STB 194 Date 8/11/95
Pump Tank: _____ Gallons; PT _____ Date _____
Pump Make: _____ Model _____ Serial No. _____
Nitrification Field: No Fields 1 Square Feet _____ Linear Feet 200
No Lines 3-4 Trench Width 24" Max Trench Bottom Depth 30" Gravel Depth N/A

☑ New System ☐ Repair System Type: I, II, III, IV, V, VI
System Description: gravity PPBPS
Repair System Description: LP PPBPS
Maintenance Agreement Required: ☐ Yes ☑ No


☑ House/Mod. Home No. Bedrooms 3
☐ Mobile Home No. Bathrooms 2
☐ Business No. Employees _____
☐ Other _____
☐ Slab ☑ Crawl Space ☐ Basement w/plumbing ☐ Basement wo/plumbing

Water Supply:
☑ Individual
☐ Community
☐ Public

Comments: Exit plumbing at existing grade in order to accomplish specified trench bottom depth.

Comments:

INITIAL SITE SKETCH

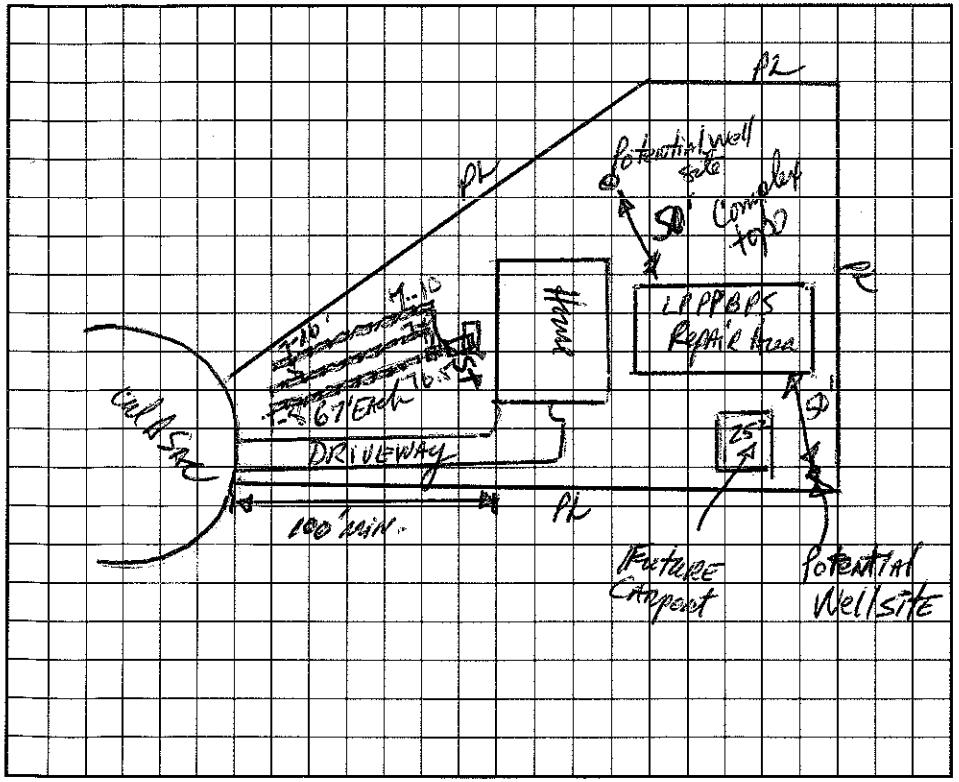

AS BUILT SKETCH

I understand that this permit can be suspended or revoked if any false information is supplied toward securing the permit/any unauthorized changes are made to the site/any unauthorized changes are made in the installation of the system. Improvement Permit is valid for 60 months from date of issuance.

Signed _____

Improvement Permit by: _____ date 3/27/95

Existing System Inspection by: Authority to Construct _____ date _____

Installed by: _____

Certificate of Completion by: _____ date _____

Operation Permit by: _____ date 10/20/95

HEALTH DEPT. COPY: WHITE INSPECTION COPY (FINAL): GREEN OWNER COPY (FINAL): YELLOW INSPECTION COPY (INITIAL): PINK OWNER COPY (INITIAL): GOLD