IREDELL COUNTY HEALTH DEPARTMENT

STATESVILLE 704-878-5305 MOORESVILLE 704-664-528[illegible]

Pete Peterso[illegible]

IMPROVEMENT PERMIT / AUTHORIZATION TO CONSTRUCT / OPERATION PERMIT / EXISTING SYSTEM INSPECTION

PERMIT# 0861610 PIN# 4637466023 DATE 12/29/99

OWNER OR CONTRACTOR Steven Lane PHONE: Business 528-6354 Home 663-3700

ADDRESS 137 Sorrell Ln. Troutman, NC 28166

LOCATION Hwy 150 W TL Doolie Rd TR Whipporwill TR Kingfisher 1/4 mile on Rt.

SUBDIVISION Whipporwill Woods BLOCK / SECTION ____ LOT 15 LOT AREA .851 Acre SITE CLASS. PS DESIGN FLOW 360gpd L.T.A.R. .3

Septic Tank: 1000 Gallons; STB 312 Dellinger Date 7-29-00
Pump Tank: 1000 Gallons; PT 27 Dellinger Date 9-1-00
Pump Make: Zoeller Model N-98-B Serial No. 98-0002
Nitrification Field: No Fields 1 Square Feet 600' Linear Feet 200'
No Lines 4 @ 50' Trench Width 36" Max Trench Bottom Depth 30" Gravel Depth N/A

☒ New System ☐ Repair System Type: I, II, III, IV, V
System Description: LP Panel Block
Repair System Description: Same
Maintenance Agreement Required: ☒ Yes ☐ No

☒ House/Mod. Home No. Bedrooms 3
☐ Mobile Home No. Bathrooms 2
☐ Business No. Employees ____
☐ Other ____


☐ Slab ☐ Crawl Space ☐ Basement w/plumbing ☒ Basement wo/plumbing

Water Supply: ☒ Individual ☐ Public ☐ Community


Comments/Conditions: Keep Septic System at least 10' from PL, 50' from Well & 25' from basement wall. Install drainlines on Contour.

Comments/Conditions: No foundation (Subsurface) drain around basement wall, therefore 15' is minimum Setback required. Approved Balance Pressure manifold per manufacturers specifications.

INITIAL SITE SKETCH Not to Scale

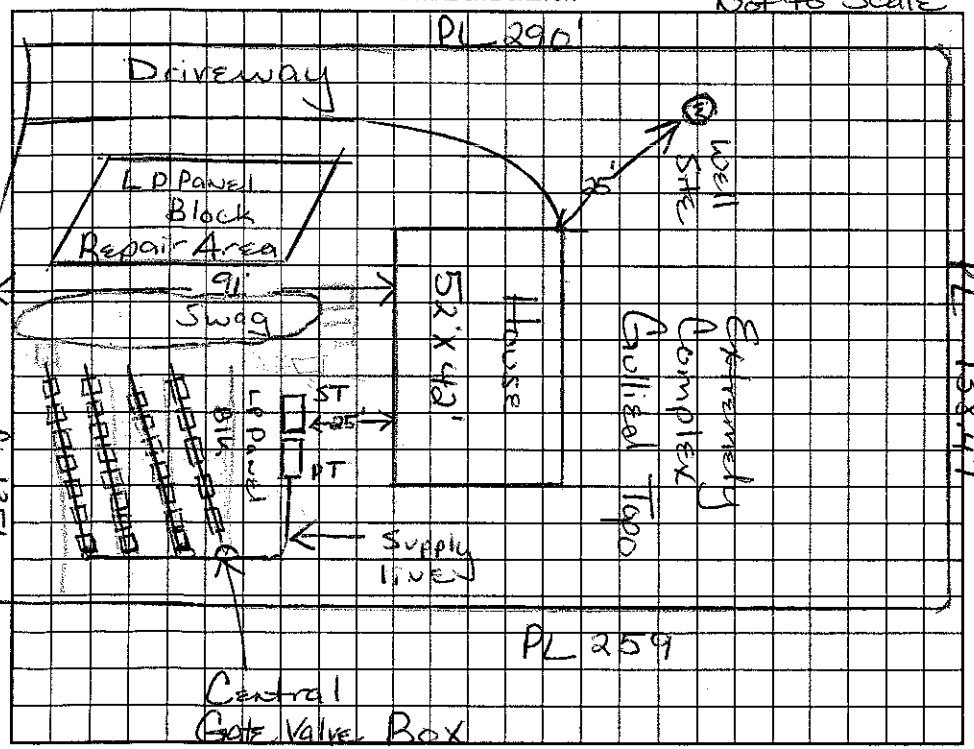

AS BUILT SKETCH

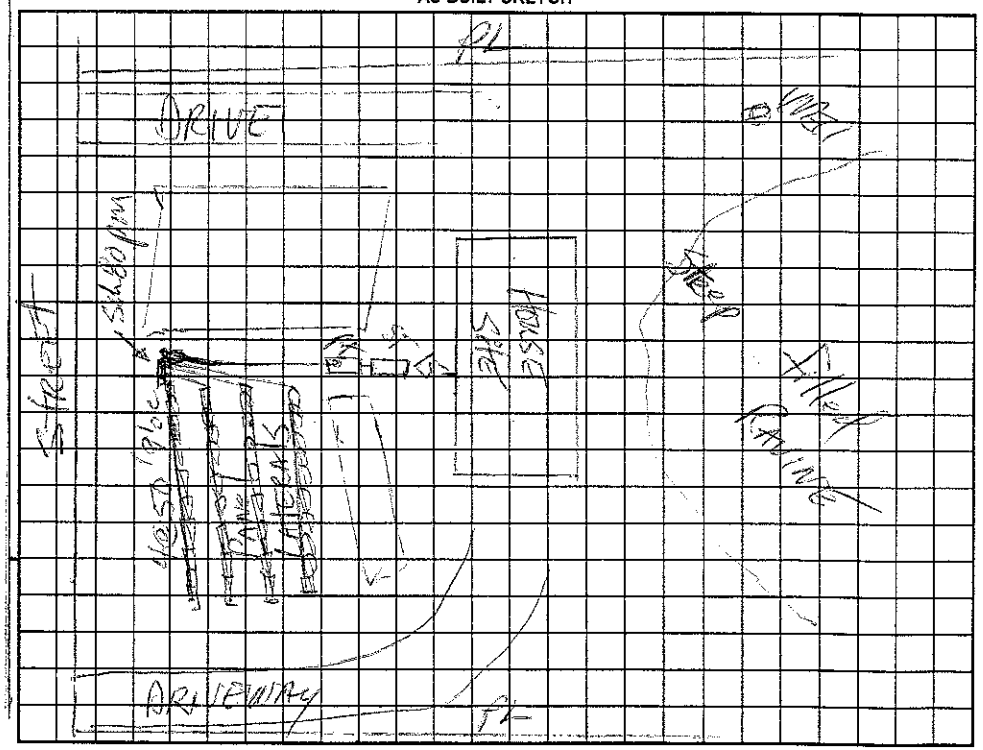

Permit can be suspended or revoked if any false information is supplied toward securing the permit/any unauthorized changes are made to the site/any unauthorized changes are made in the installation of the system. Improvement Permit with plat valid without expiration. Improvement Permit with site plan valid for sixty months. Authorization to Construct is valid for a period equal to that of Improvement Permit – not to exceed sixty months.

Signed: Lee Spary date 1-12-00 Installed by: Perry Laney

Improvement Permit by: Maria H. Dotson RS. date 12/29/99 Operation Permit by: Wesley Sparks R.S. date 10/30/00

Authorization to Construct by: Maria H. Dotson RS. date 12/29/99 Existing System Inspection by: ____ date ____

HEALTH DEPT. COPY: WHITE OWNER COPY (FINAL): YELLOW OWNER COPY (INITIAL): PINK