IREDELL COUNTY HEALTH DEPARTMENT

STATESVILLE 704-878-5305 MOORESVILLE 704-664-5281

IMPROVEMENT PERMIT / AUTHORIZATION TO CONSTRUCT / OPERATION PERMIT / EXISTING SYSTEM INSPECTION

PERMIT# 18199 PIN# ~~Pt of 2CP15~~ 4637-46-9738 DATE 6/24/99

OWNER OR CONTRACTOR Richard Page PHONE: Business Home 363-3710

ADDRESS 178 Southwood Park Rd. Mooresville, NC. 28117

LOCATION 150 W TL Doolie Rd. TR Purple Finch, last lot on (L) before cul de sac

SUBDIVISION Whippoorwill Wds BLOCK / SECTION 2 LOT 12 LOT AREA ~ 60,000 Ft² SITE CLASS. PS DESIGN FLOW 360 L.T.A.R. .3

Septic Tank: 1000 Gallons; STB 312 Date 9/29/99
Pump Tank: 1000 Gallons; PT 27 Date 10/23/99
Pump Make: GOULDS Model WE0-311L Serial No. 19834443
Nitrification Field: No. Fields 1 Square Feet 630 * Linear Feet 210 *
No Lines 3 Trench Width 36" Max Trench Bottom Depth ~~30~~ 28" Gravel Depth SAND

[X] New System [ ] Repair System Type: I, II, III (IV) V, VI
System Description: Low Pres - 16" PPBS - 16"
Repair System Description: Same System
Maintenance Agreement Required: [X] Yes [ ] No

[X] House/Mod. Home No. Bedrooms 3
[ ] Mobile Home No. Bathrooms 3
[ ] Business No. Employees
[ ] Other


[ ] Slab [X] Crawl Space [ ] Basement w/plumbing [ ] Basement wo/plumbing

Water Supply: [X] Individual [ ] Public [ ] Community


Comments:/Conditions:

Comments:/Conditions: 12/3/99 Inspected Tanks, Drainlines, and Piping - AWS

INITIAL SITE SKETCH (1" = 50')

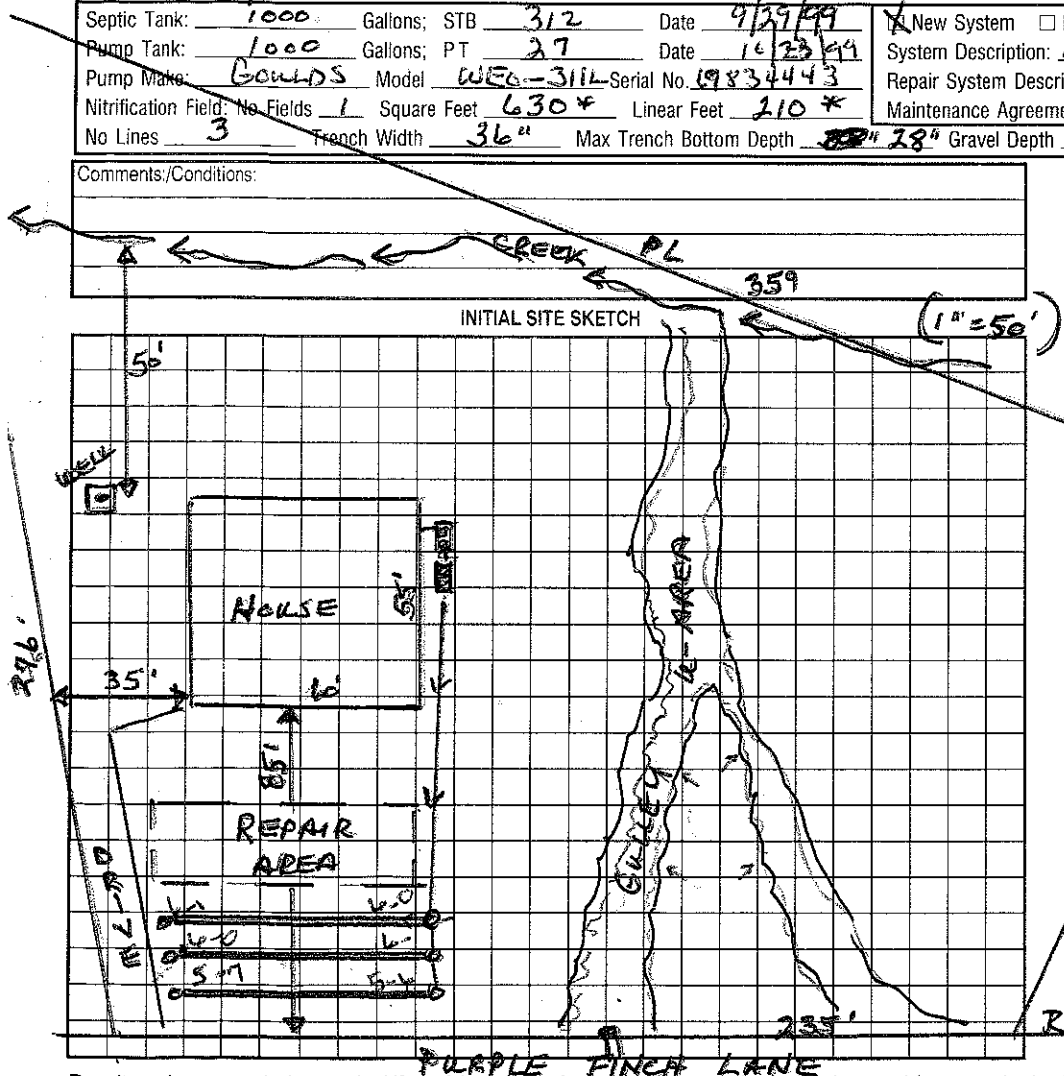

AS BUILT SKETCH

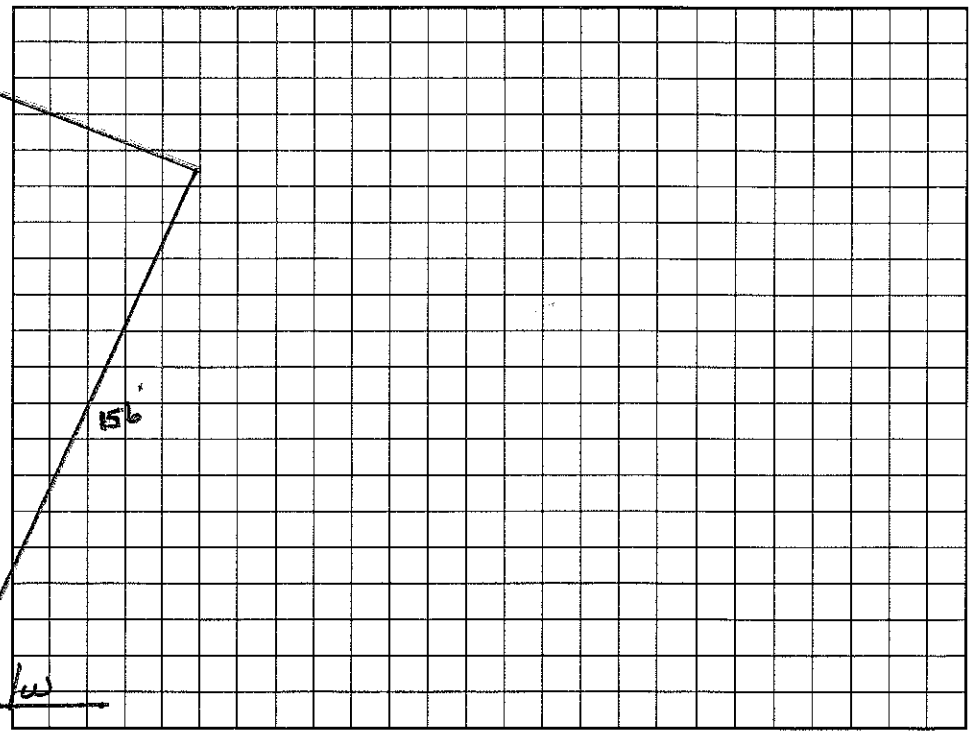

Permit can be suspended or revoked if any false information is supplied toward securing the permit/any unauthorized changes are made to the site/any unauthorized changes are made in the installation of the system. Improvement Permit with plat valid without expiration. Improvement Permit with site plan valid for sixty months. Authorization to Construct is valid for a period equal to that of Improvement Permit – not to exceed sixty months.

Signed: X Richard Page date

Installed by: A CORNELIUS GRADING

Improvement Permit by: Wesley Sparks RS. date 6/28/99

Operation Permit by: Wesley Sparks R.S. date 1/24/00

Authorization to Construct by: Wesley Sparks R.S. date 6/28/99

Existing System Inspection by: date

HEALTH DEPT. COPY: WHITE OWNER COPY (FINAL): YELLOW OWNER COPY (INITIAL): PINK