IREDELL COUNTY HEALTH DEPARTMENT ~~STATESVILLE~~ 704-878-5305 MOORESVILLE 704-664-5281

IMPROVEMENT PERMIT / AUTHORIZATION TO CONSTRUCT / OPERATION PERMIT / EXISTING SYSTEM INSPECTION

PERMIT # 164140 PIN # 4637531615 DATE 12-2-2010

OWNER or APPLICANT Josh & Cristina Perry / EFC Assoc PHONE: Business 704 528-5221 Home: 704 663-6738

OWNER or APPLICANT ADDRESS 420 Main St. / Troutman, NC

LOCATION / DIRECTIONS Brawley School Rd TR Oak Tree When road turns go straight onto Gravel Rd (Happy Oaks) on left

SUBDIVISION Timberlane Shores BLOCK / SECTION LOT # 7 LOT AREA DESIGN FLOW 360gpd L.T.A.R.

Existing

Septic Tank 1500 Gallons: STB Date
Pump Tank Gallons: P T Date
Pump Make Model Serial #
Nitrification Field No Fields 1 No Lines 2 Linear Feet 150'
Trench Width — Max. Trench Bottom Depth Gravel Depth N/A

☐ New System ☐ Repair ☐ Expansion System Type I II III IV V VI
System Description: Existing Gravity-Panel BK
Repair System Description: To be determined
Maintenance Agreement Required ☐ YES ☐ NO
☒ GRAVITY ☐ PRESSURE


☒ Residence No. Bedrooms 3
☐ Business No. Persons
☐ Other No. Employees
☐ Slab ☐ Crawl Space
☐ Basement w/plumbing ☐ Basement w/o plumbing

Water Supply: ☒ Private ☐ Public ☐ Community


Comments / Conditions: Existing Septic System appears to be functioning okay at time of inspection

Comments / Conditions: ~~X~~ Must keep Footers and/or Piers at least 5ft from Septic System. Do not place impervious Materials over Septic System.

INITIAL SITE SKETCH

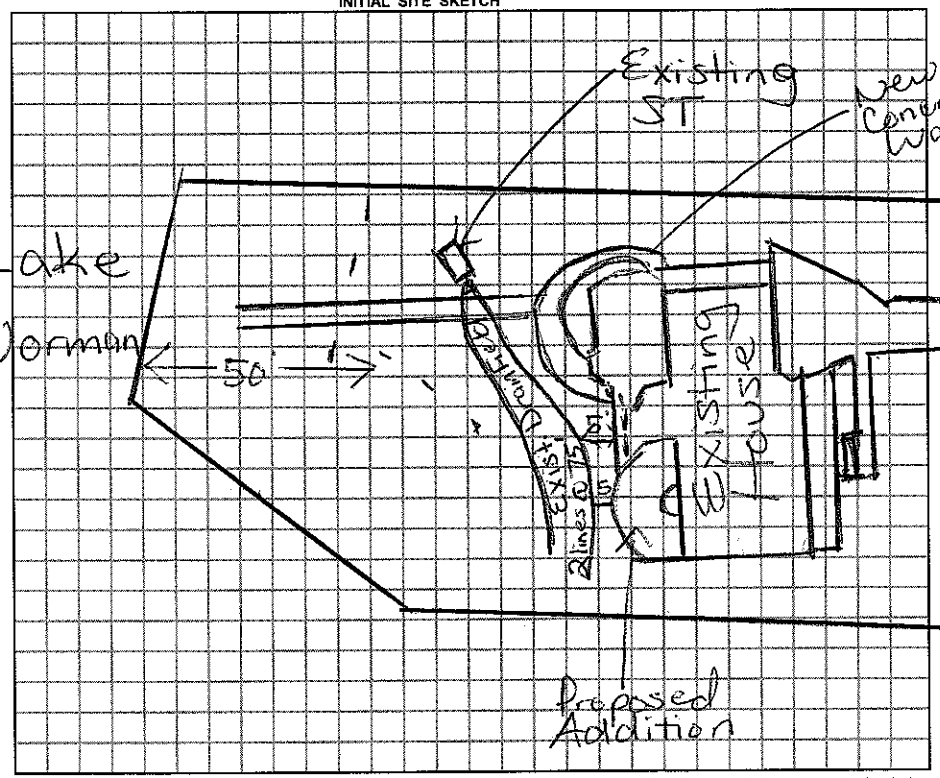

AS BUILT SKETCH

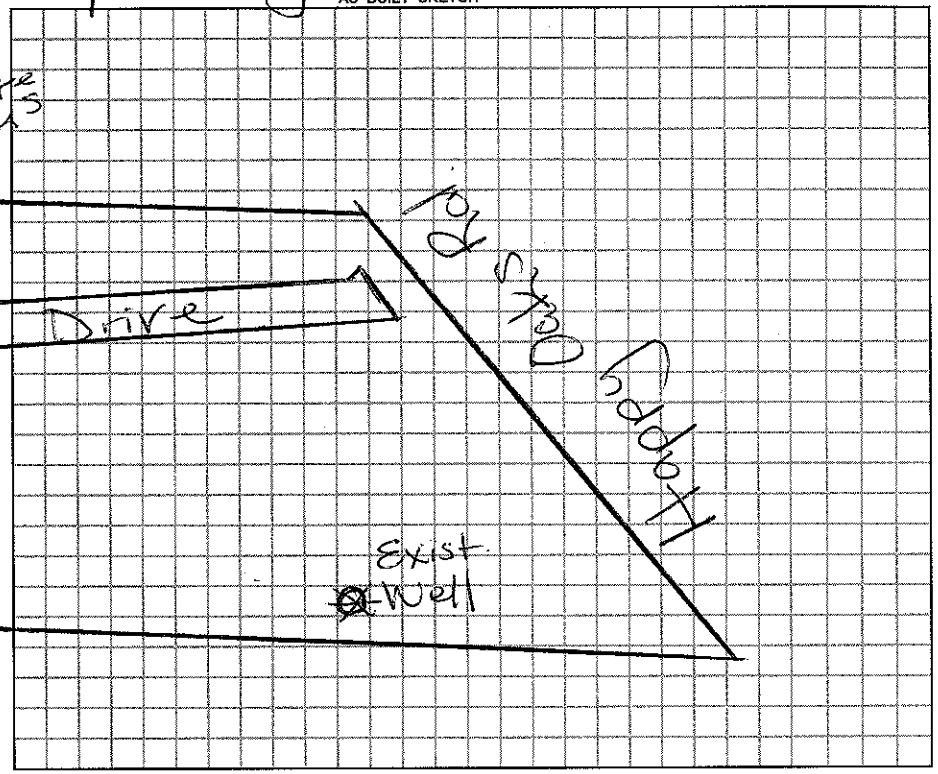

Permit can be suspended or revoked if any false information is supplied toward securing the permit / any unauthorized changes are made to the site / any unauthorized changes are made in the installation of the system.

☐ *IMPROVEMENT PERMIT w / plat valid without expiration.* ☐ *IMPROVEMENT PERMIT w / site plan valid for 60 mos.* ☐ *AUTHORIZATION TO CONSTRUCT valid for period equal to IMPROVEMENT PERMIT-not to exceed 60 mo.*

Owner / Applicant Signature: D M Beam Date 12/3/10

Improvement Permit by: Date

Authorization to Construct by: Date

Installed by: Ray Beam 9-29-86

Operation Permit by: Date

Existing System Inspected by: Date: 12/2/2010 RS

YOU SHOULD CONTACT A LOCATOR SERVICE PRIOR TO ANY EXCAVATION.

WHITE COPY Environmental Health YELLOW COPY (Final) Owner / Applicant PINK COPY (Initial) Owner / Applicant