IREDELL COUNTY HEALTH DEPARTMENT

STATESVILLE 704-878-5305 130.00 Paid MOORESVILLE 704-664-5281 1:30

IMPROVEMENT PERMIT / AUTHORIZATION TO CONSTRUCT / OPERATION PERMIT / EXISTING SYSTEM INSPECTION

PERMIT# 109567 PIN# 4637541746 DATE 11-18-2002

OWNER OR CONTRACTOR Thomas & Penelope Gregory PHONE: Business (375-3375 Home (704) 375-6817

ADDRESS 1624 Biltmore Dr. Charlotte, NC 28207 327 Doolie M'ville 28677

LOCATION Hwy 150 West TL Doolie Rd to end of road (after it curves) on left #327.

SUBDIVISION C & T BLOCK / SECTION 10 LOT 3 LOT AREA .67 Acre SITE CLASS PS DESIGN FLOW 360 gpd L.T.A.R. .3

Septic Tank: 1000 Gallons; STB 794 Date 3-20-04
Pump Tank: ____ Gallons; PT ____ Date ____
Pump Make: ____ Model ____ Serial No. ____
Nitrification Field: No Fields 1 Square Feet 400'-600' Linear Feet 200'
No Lines 4 @ 50' Trench Width 24"-36" Max Trench Bottom Depth 30" Gravel Depth N/A

X New System ☐ Repair System Type: I II III IV V VI
System Description: Gravity-Panel Block
Repair System Description: Pump (4) Panel Blk
Maintenance Agreement Required: ☐ Yes X No Not Initially

X House/Mod. Home ☐ Mobile Home ☐ Business office & Game Rm. ☐ Other did not qualify as Bedrooms
No. Bedrooms 3 No. Bathrooms 1.5 No. Employees ____


Water Supply: X Individual ☐ Public ☐ Community

☐ Slab X Crawl Space ☐ Basement w/plumbing ☐ Basement wo/plumbing

Comments/Conditions:

Comments/Conditions: Must "Stub out" plumbing high (high crawl space) to maintain gravity flow from ST to Drainfield Otherwise Sewage will have to be pumped.

INITIAL SITE SKETCH

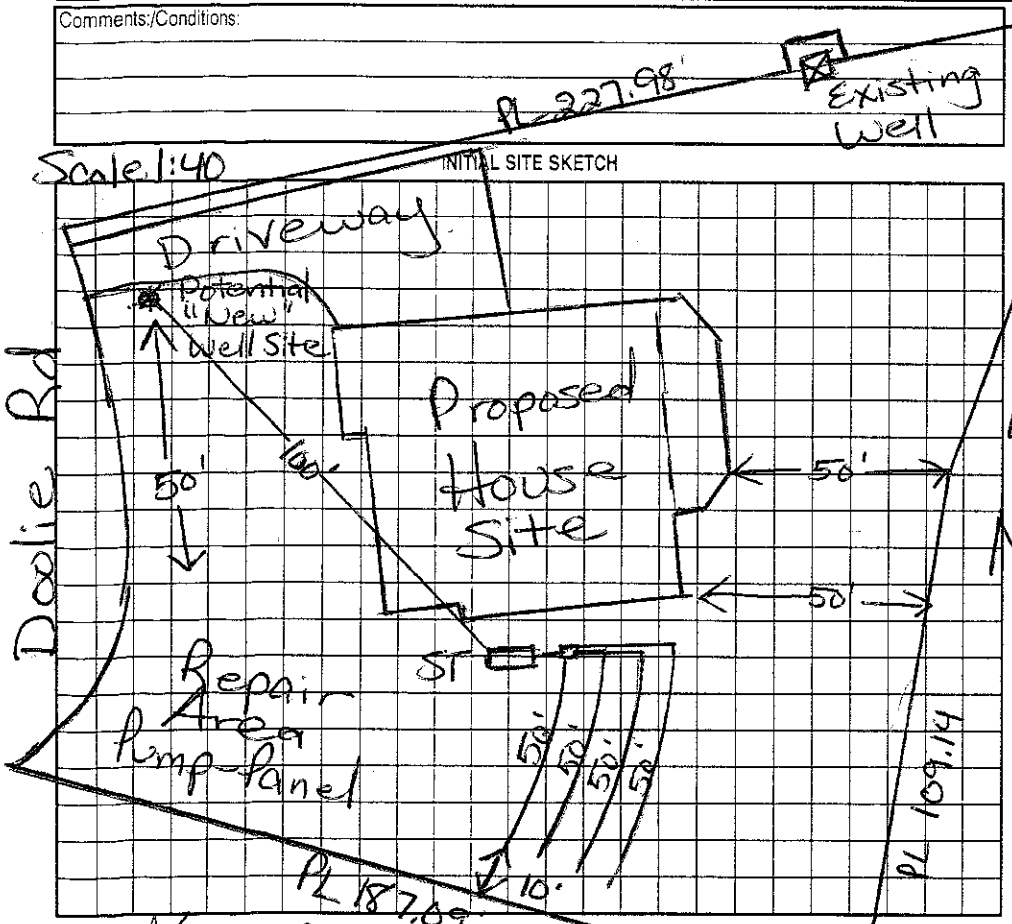

AS BUILT SKETCH

50% Reduction in Drainfield area

Installed as Drawn

Permit can be suspended or revoked if any false information is supplied toward securing the permit/any unauthorized changes are made to the site/any unauthorized changes are made in the installation of the system. Improvement Permit with plat valid without expiration. Improvement Permit with site plan valid for sixty months. Authorization to Construct is valid for a period equal to that of Improvement Permit – not to exceed sixty months.

Signed: Thomas C Gregory date 11/25/2002 Installed by: Richard Abernathy

Improvement Permit by: Maria H. Dotson R.S. date 11/18/2002 Operation Permit by: Maria H. Dotson R.S. date 5/25/04

Authorization to Construct by: Maria H. Dotson R.S. date 11/18/2002 Existing System Inspection by: ____ date ____

HEALTH DEPT. COPY: WHITE OWNER COPY (FINAL): YELLOW OWNER COPY (INITIAL): PINK