authorization to Construct 4637542633 1 30

IREDELL COUNTY HEALTH DEPARTMENT

STATESVILLE 704-878-5305 MOORESVILLE 704-664-5281

IMPROVEMENT PERMIT / ~~CERTIFICATE OF COMPLETION~~ / OPERATION PERMIT / EXISTING SYSTEM INSPECTION

PROPERTY DESCRIPTION NO. 22272 DATE 3/21/96 TAX MAP NO. 2P 3A 2 Watershed: [X] Yes ☐ No

OWNER OR CONTRACTOR Harry D. Letourneau Jr. PHONE: Business ______ Home 664-3236

ADDRESS 325 Doolie Rd. Mooresville, NC. 28115

LOCATION Doolie Rd., 150 ft Doolie Rd. Lane (R), 2nd driveway (L)

SUBDIVISION CL+T BLOCK / SECTION 10 LOT 2 LOT AREA .9AC SITE CLASS. PS DESIGN FLOW 360 L.T.A.R. .3

Septic Tank: 1000 Gallons; STB 794 Date 3/6/97

Pump Tank: ______ Gallons; PT ______ Date ______

Pump Make: ______ Model ______ Serial No. ______

Nitrification Field: No Fields 1 Square Feet 1200 Linear Feet 200*

No Lines 3 Trench Width 24" Max Trench Bottom Depth 36" Gravel Depth 6" SAND

[X] New System ☐ Repair System Type: I, II, (III), IV, V, VI

System Description: GRAVITY - PPBS 16"

Repair System Description: SAME

Maintenance Agreement Required: ☐ Yes ☐ No

[X] House/Mod. Home ☐ Mobile Home ☐ Business ☐ Other

No. Bedrooms 3 No. Bathrooms 3.5 No. Employees ______

☐ Slab [X] Crawl Space ☐ Basement w/plumbing ☐ Basement wo/plumbing


Water Supply: [X] Individual ☐ Community ☐ Public

Comments: *16" PPBS ON CONTOUR IN AREA SHOWN - VERY TIGHT - CONTRACTOR GET QUESTIONS ANSWERED BY ICHD BEFORE DIGGING.

Comments:

INITIAL SITE SKETCH

AS BUILT SKETCH

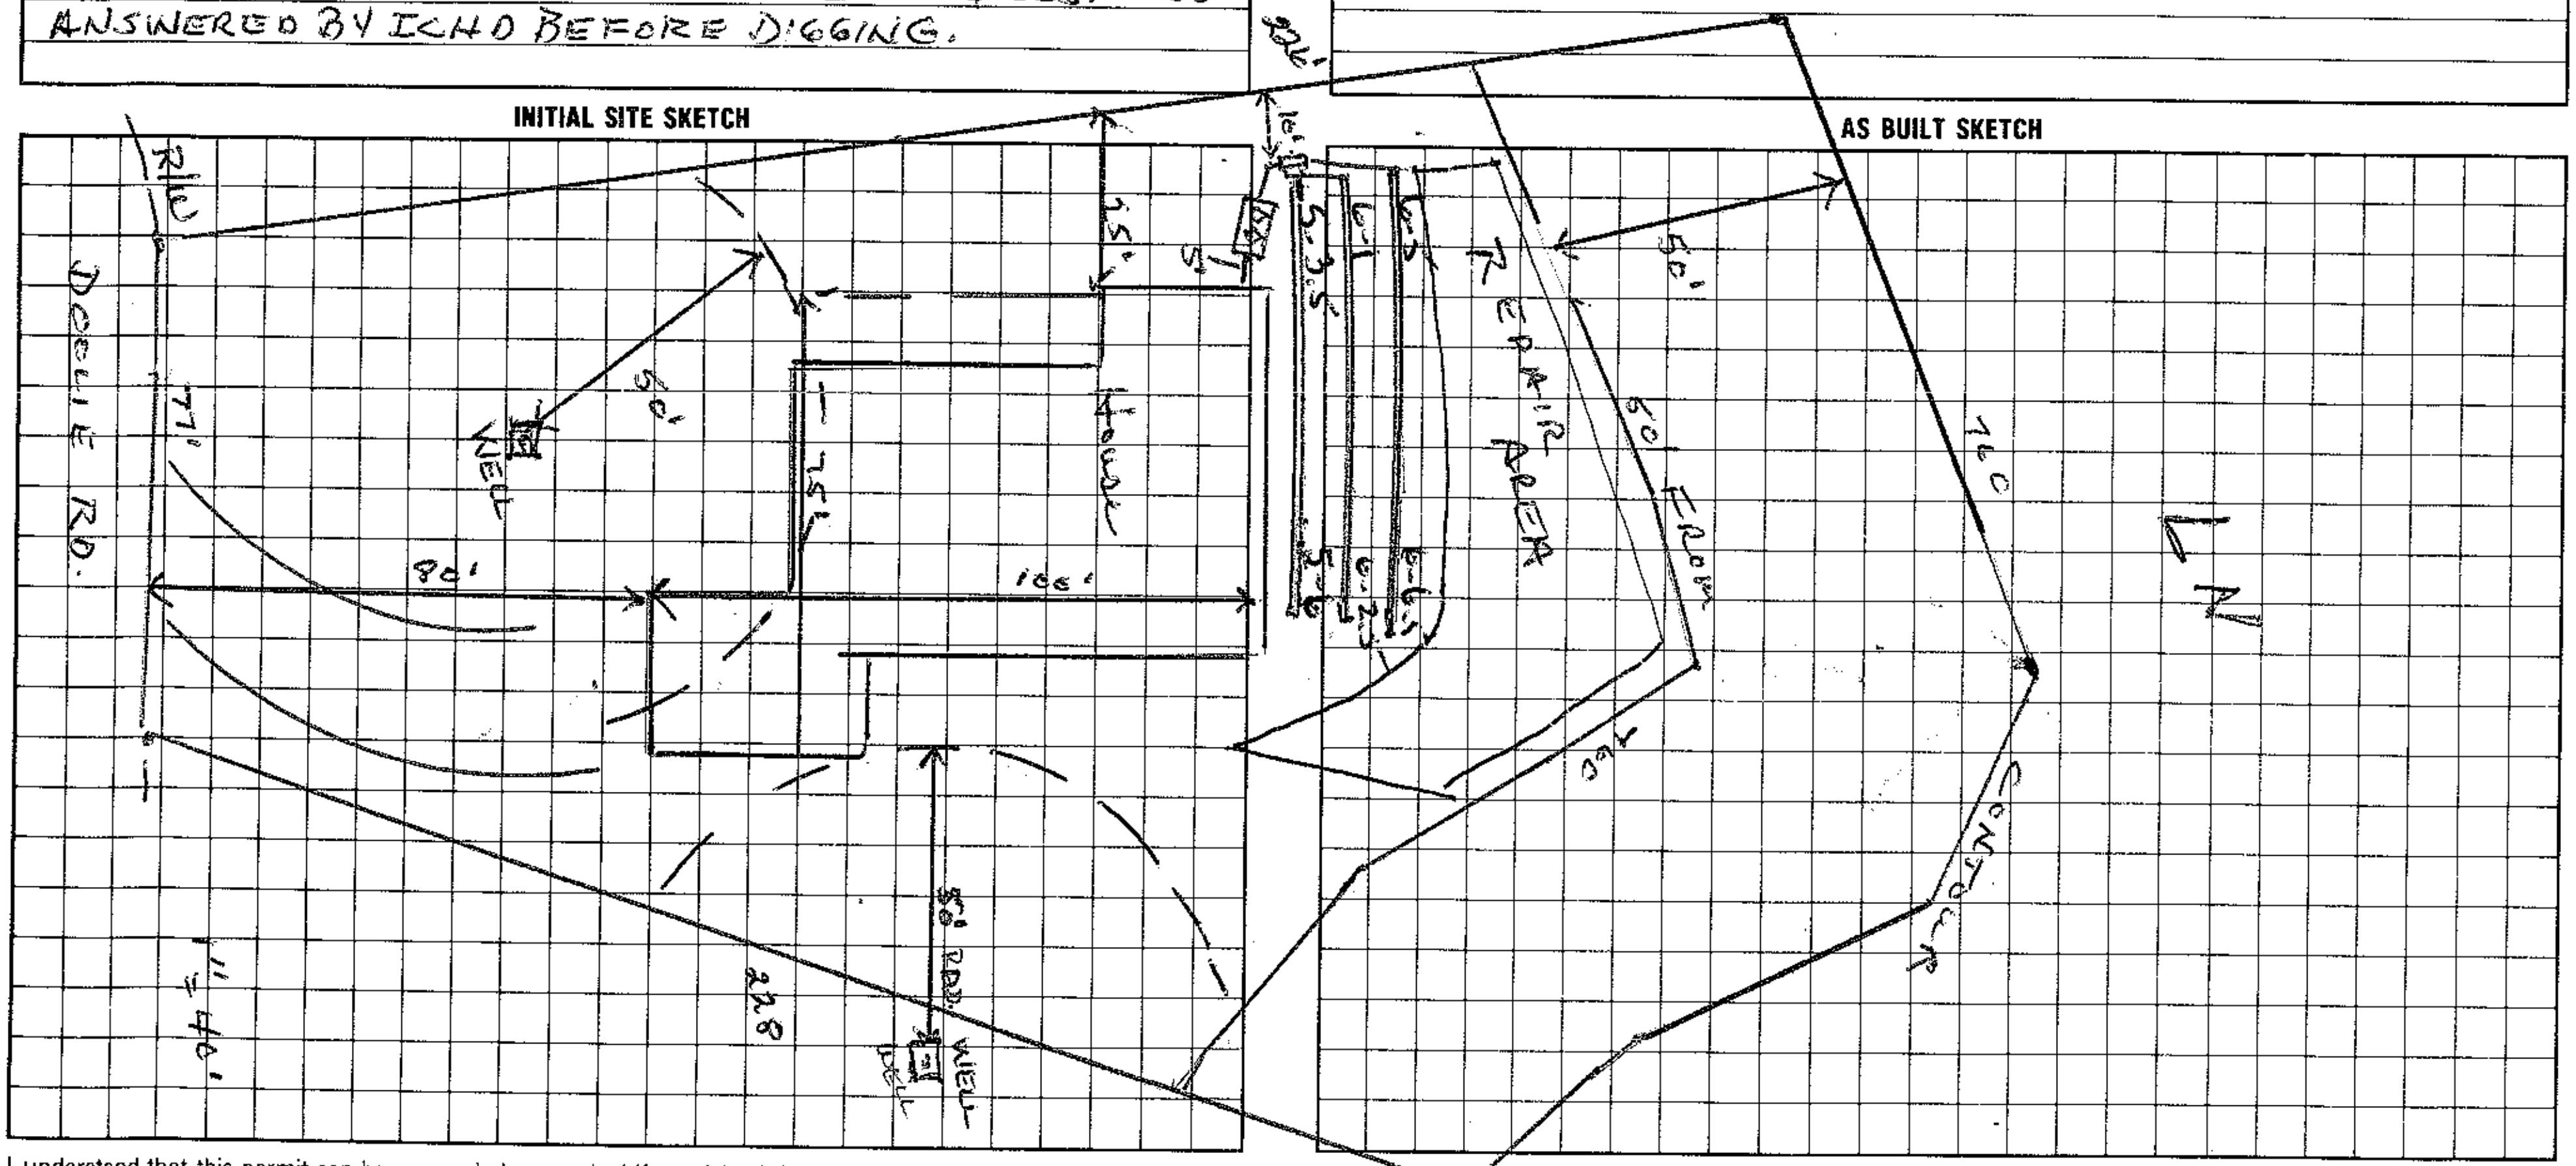

I understand that this permit can be suspended or revoked if any false information is supplied toward securing the permit/any unauthorized changes are made to the site/any unauthorized changes are made in the installation of the system.

Authorization to construct valid 5 years.

Signed: Terry R. Letourneau

Improvement Permit by: Wesley Sparks R.S. date 3/21/96

Authorization to Construct ~~Existing System Inspection by~~ Wesley Sparks RS date 3/21/96

Installed by: Denver Plumbing

Certificate of Completion by: Wesley Sparks R.S. date 5/7/97

Operation Permit by: Wesley Sparks R.S. date 5/7/97

HEALTH DEPT. COPY: WHITE INSPECTION COPY (FINAL): GREEN OWNER COPY (FINAL): YELLOW INSPECTION COPY (INITIAL): PINK OWNER COPY (INITIAL): GOLD