IREDELL COUNTY HEALTH DEPARTMENT

STATESVILLE 704-878-5305 MOORESVILLE 704-664-5281

IMPROVEMENT PERMIT / CERTIFICATE OF COMPLETION / OPERATION PERMIT / EXISTING SYSTEM INSPECTION

PROPERTY DESCRIPTION NO. 15278 DATE 9/15/93 TAX MAP NO. 2P 3A 9

OWNER OR CONTRACTOR RON LILLY PHONE: Business Home 664-5141

ADDRESS Rt 8 BOX 795-H MOORESVILLE, NC. 28115 4637 55 1190

LOCATION DOOLIE RD. ON (R) NEAR END.

SUBDIVISION CL+T BLOCK / SECTION LOT 1170 LOT AREA SITE CLASS. P L.T.A.R.

Water Supply: ☑ Individual ☐ Community ☐ Public

Septic Tank: 1600 Gallons; STB 794 Date N/A

Pump Tank: 1000 Gallons; PT 788 Date N/A

Nitrification Field: No Fields 1 Square Feet 900 Linear Feet 500 (EXISTING)

No Lines 3 Trench Width 3' Trench Depth 3' Gravel Depth 12"

☑ New System ☐ Repair System Type: I, II, II, IV, V, VI

System Description: PUMP TO CONV.

Repair System Description: CONV. GRAVITY

Maintenance Agreement Required: ☐ Yes ☑ No

☑ House/Mod. Home ☐ Mobile Home ☐ Business ☐ Other

No. Bedrooms 3 No. Bathrooms 2.5 No. Employees

☐ Slab ☐ Crawl Space ☑ Basement w/plumbing ☐ Basement wo/plumbing

Garbage Disposal: ☐ Yes ☑ No


Auto. Dishwasher: ☑ Yes ☐ No

Auto. Washing Machine: ☑ Yes ☐ No


Other

Comments

INITIAL SITE SKETCH

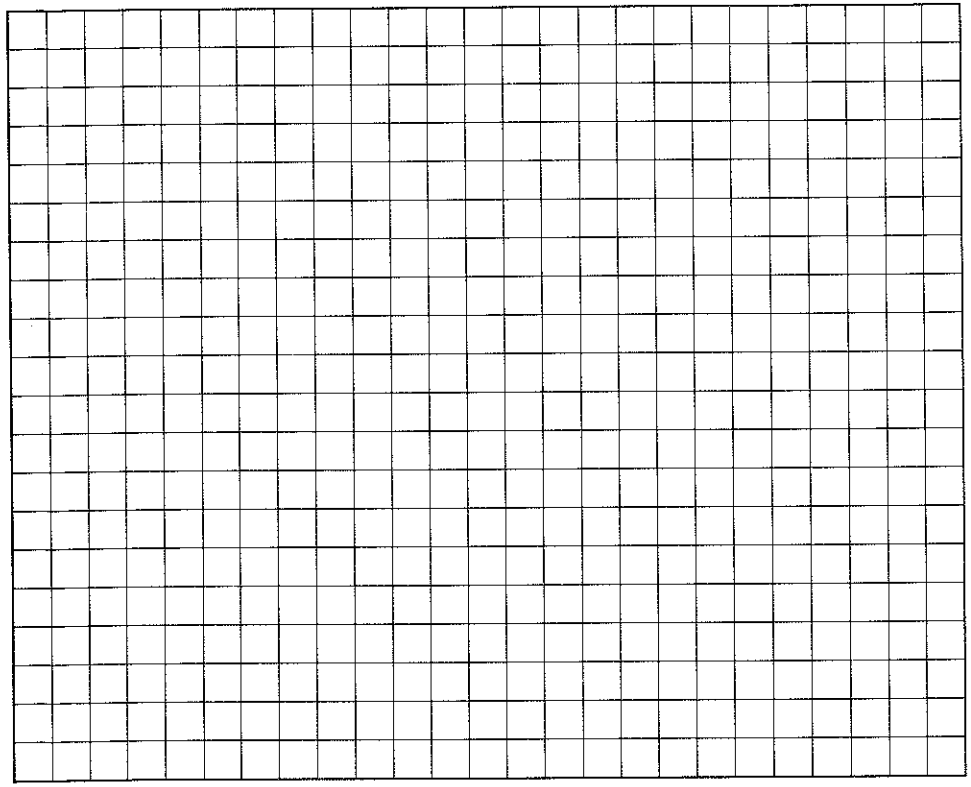

AS BUILT SKETCH

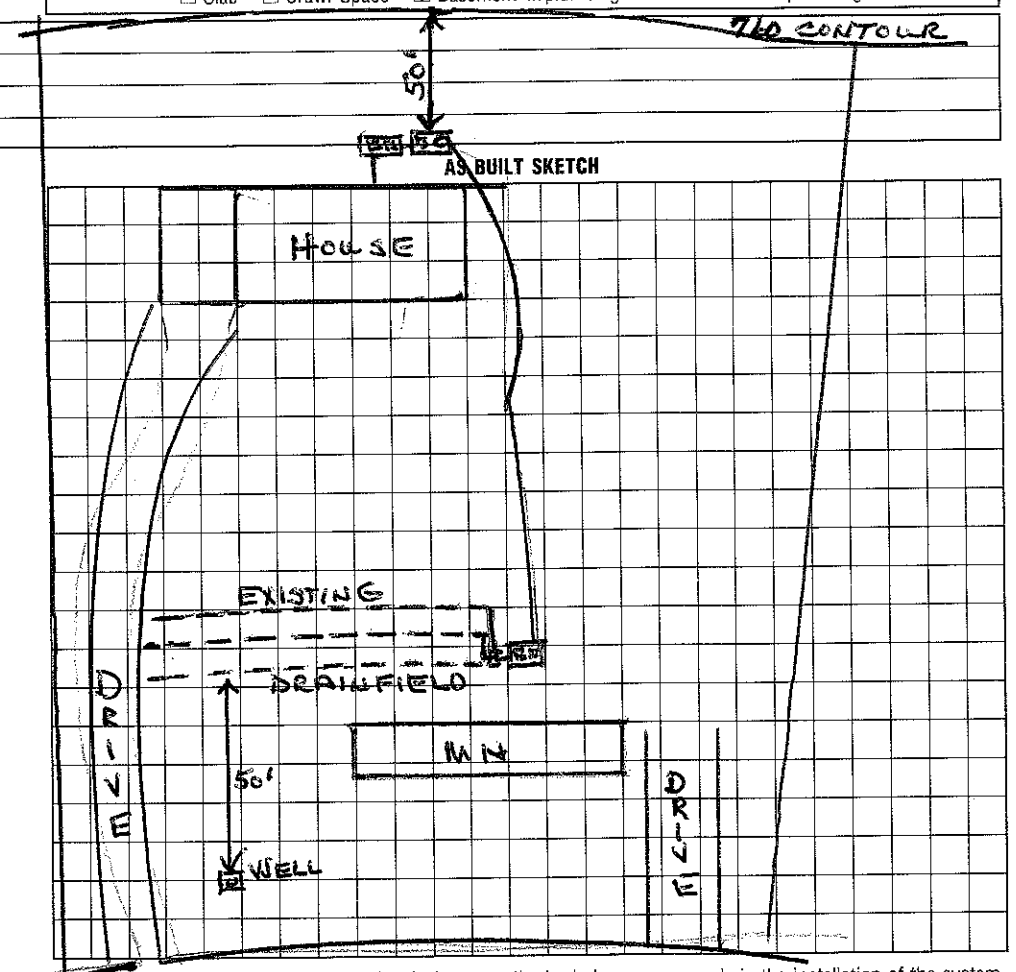

I understand that this permit can be suspended or revoked if any false information is supplied toward securing the permit/any unauthorized changes are made to the site/any unauthorized changes are made in the installation of the system. Improvement Permit is valid for 60 months from date of issuance.

DOOLIE RD.

Signed:

Improvement Permit by: date

Existing System Inspection by: date

Installed by: FJ Erwin

Certificate of Completion by: Wesley Sparks RS. date 9/15/93

Operation Permit by: date

HEALTH DEPT. COPY: WHITE INSPECTION COPY (FINAL): GREEN OWNER COPY (FINAL): YELLOW INSPECTION COPY (INITIAL): PINK OWNER COPY (INITIAL): GOLD