IREDELL COUNTY HEALTH DEPARTMENT

AUTH. / TO CONSTRUCT

STATESVILLE 704-878-5305 MOORESVILLE 704-664-5281

IMPROVEMENT PERMIT / ~~CERTIFICATE OF COMPLETION~~ / OPERATION PERMIT / EXISTING SYSTEM INSPECTION

PROPERTY DESCRIPTION NO. 25095 DATE 8 9/23/96 TAX MAP NO. 2-P-14-A-1 Watershed: ☑ Yes ☐ No

OWNER OR CONTRACTOR JON GREGORIAN PHONE: Business _____ Home 664-3400

ADDRESS 308 WILLIAMSON RD MOORESVILLE

LOCATION 150 W-TL DOOLIE - TR WHITEHALL - CORNER LOT

SUBDIVISION WHITEHALL WOODS BLOCK / SECTION _____ LOT 1 LOT AREA 145X240 SITE CLASS. PS DESIGN FLOW 360 GPD L.T.A.R. .36 PD/FT²

Septic Tank: 1000 Gallons; STB 794 Date 11/13/97

Pump Tank: _____ Gallons; PT _____ Date _____

Pump Make: _____ Model _____ Serial No. _____

Nitrification Field: No Fields 1 Square Feet 900 Linear Feet 300

No Lines @ 3 Trench Width 36" Max Trench Bottom Depth 36" Gravel Depth N/A

☑ New System ☐ Repair System Type: I, II, III, IV, V, VI

System Description: GRAVITY CHAMBER

Repair System Description: PUMP CHAMBER

Maintenance Agreement Required: ☐ Yes ☑ No

☑ House/Mod. Home No. Bedrooms 3

☐ Mobile Home No. Bathrooms 2

☐ Business No. Employees ____

☐ Other _____


☐ Slab ☑ Crawl Space ☐ Basement w/plumbing ☐ Basement wo/plumbing

Water Supply: ☑ Individual ☐ Community ☐ Public

Comments:

Comments:

INITIAL SITE SKETCH

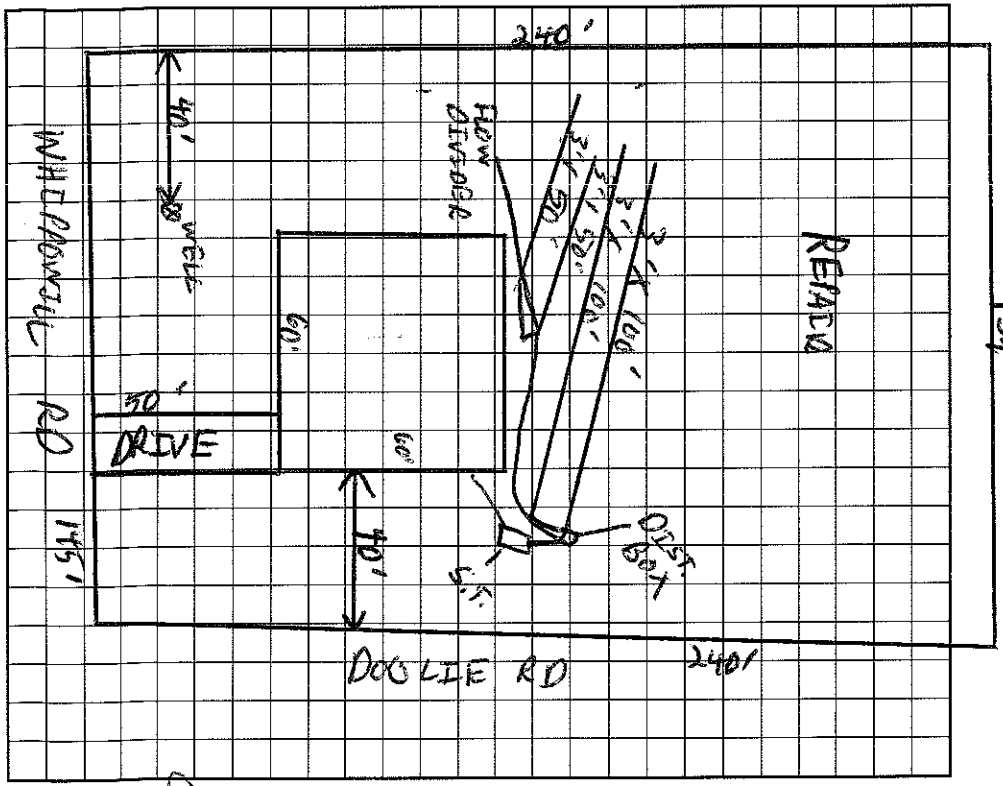

AS BUILT SKETCH

I understand that this permit can be suspended or revoked if any false information is supplied toward securing the permit/any unauthorized changes are made to the site/any unauthorized changes are made in the installation of the system.

Signed: _____

Improvement Permit by: C. Ray Teem EHSI date 9/23/96

AUTH. TO CONSTRUCT Existing System Inspection by: C Ray Teem EHSI date 9/23/96

Installed by: Dave Clark

Certificate of Completion by: Wesley Sparks RS. date 2/13/98

Operation Permit by: Wesley Sparks RS. date 2/13/98

HEALTH DEPT. COPY: WHITE INSPECTION COPY (FINAL): GREEN OWNER COPY (FINAL): YELLOW INSPECTION COPY (INITIAL): PINK OWNER COPY (INITIAL): GOLD