IREDELL COUNTY HEALTH DEPARTMENT

STATESVILLE 704-878-5305 MOORESVILLE 704-664-5281

IMPROVEMENT PERMIT / AUTHORIZATION TO CONSTRUCT / OPERATION PERMIT / EXISTING SYSTEM INSPECTION

PERMIT # 163562 & 163563 PIN # 4637553999 DATE 10-27-2010

OWNER or APPLICANT Colleen Tritt PHONE: Business 704 799-7200 Home:

OWNER or APPLICANT ADDRESS 104 Whippoorwill Rd Mooresville, NC 28117

LOCATION / DIRECTIONS Hwy 150 W. PPL Dodie TR Whippoorwill Rd on right at corner

SUBDIVISION Whippoorwill Woods BLOCK / SECTION LOT # 1 LOT AREA DESIGN FLOW 360gpd L.T.A.R. .3

EXIST

Septic Tank 1000 Gallons: STB Date

Pump Tank Gallons: PT Date

Pump Make Model Serial #

Nitrification Field No Fields 1 No Lines 3 Linear Feet 300

Trench Width 36" Max. Trench Bottom Depth Exist Gravel Depth N/A

☐ New System ☐ Repair ☐ Expansion System Type I II III IV V VI

System Description: EXIST. Gravity - 25% Reduction

Repair System Description: Pump - 25-50% Reduct.

Maintenance Agreement Required ☐ YES ☐ NO

☒ GRAVITY ☐ PRESSURE


☒ Residence No. Bedrooms 3 ☐ Business No. Persons ☐ Other No. Employees ☐ Slab ☐ Crawl Space ☐ Basement w/plumbing ☐ Basement w/o plumbing

Water Supply: ☒ Private ☐ Public ☐ Community


Comments / Conditions: Must Keep "pool Cut" at least 15Ft from Septic System (including Repair) Keep Garage at least 5Ft from Septic

Comments / Conditions: Existing Septic System appears to be Functioning Okay at time of inspection

INITIAL SITE SKETCH

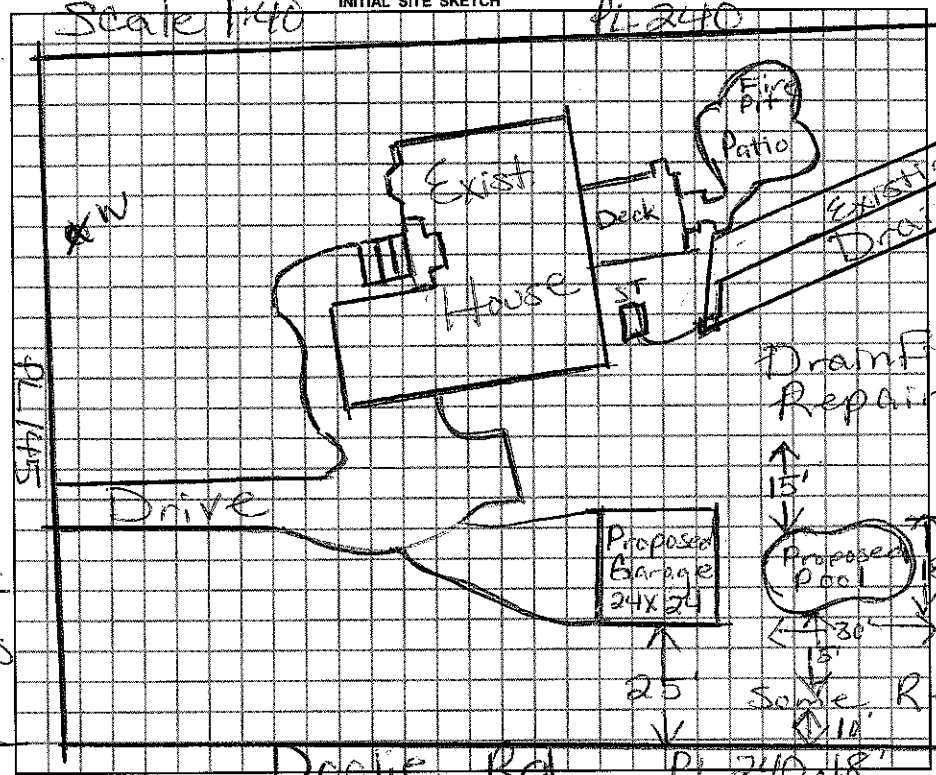

AS BUILT SKETCH

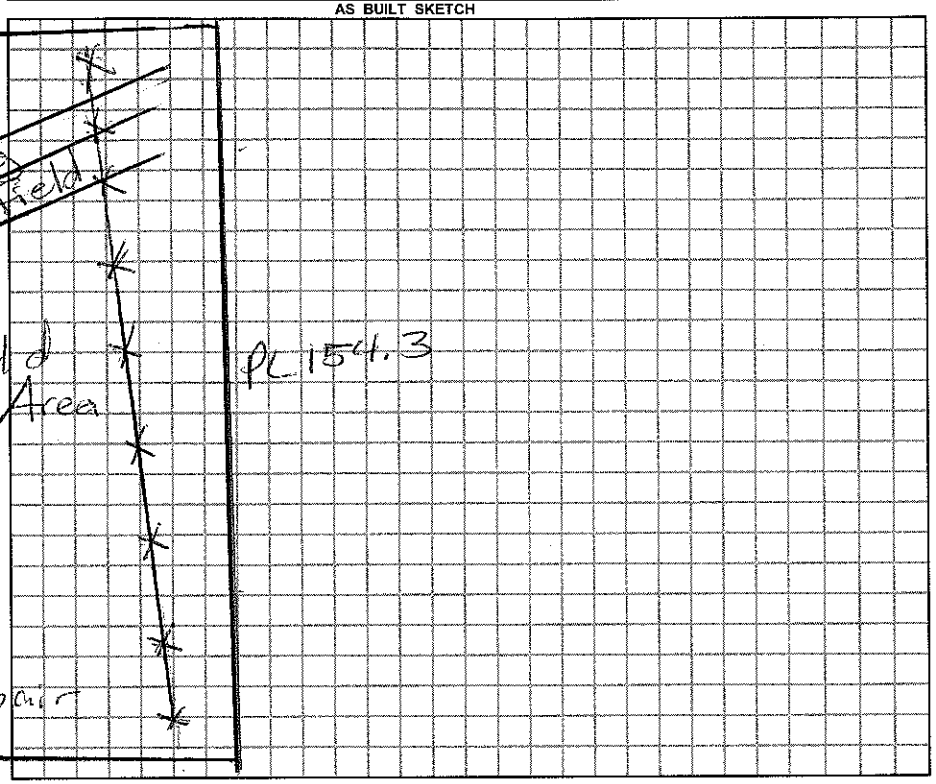

Permit can be suspended or revoked if any false information is supplied toward securing the permit / any unauthorized changes are made to the site / any unauthorized changes are made in the installation of the system.

☐ *IMPROVEMENT PERMIT w / plat valid without expiration.* ☒ *IMPROVEMENT PERMIT w / site plan valid for 60 mos.* ☐ *AUTHORIZATION TO CONSTRUCT valid for period equal to IMPROVEMENT PERMIT-not to exceed 60 mo.*

Owner / Applicant Signature: Michael R Tritt Date 10/28/10

Improvement Permit by: Date

Authorization to Construct by: Date

YOU SHOULD CONTACT A LOCATOR SERVICE PRIOR TO ANY EXCAVATION.

Installed by:

Operation Permit by: Date:

Existing System Inspected by: Maria H Dolan RS Date: 10/27/2010

WHITE COPY Environmental Health YELLOW COPY (Final) Owner / Applicant PINK COPY (Initial) Owner / Applicant