IREDELL COUNTY HEALTH DEPARTMENT

STATESVILLE 704-878-5305 MOORESVILLE 704-664-5281

IMPROVEMENT PERMIT / AUTHORIZATION TO CONSTRUCT / OPERATION PERMIT / EXISTING SYSTEM INSPECTION

PERMIT# 17990 PIN# 2P 14 A 3 4637 56 0091 DATE 12/7/98

OWNER OR CONTRACTOR A. Sherman Const Co. PHONE: Business 662-0145 Home

ADDRESS 1240 A Rivers Hwy. Mrsh.

LOCATION Whippoorwill Rd. 150' W To Doolie Rd. TR Whippoorwill to 3rd lot on (R)

SUBDIVISION Whippoorwill Woods BLOCK / SECTION LOT 3 LOT AREA ~ 1.19 Ac SITE CLASS. RS DESIGN FLOW 360 L.T.A.R. .35

Septic Tank: 1000 Gallons; STB 794 Date 8/29/98 ☒ New System ☐ Repair System Type: I, II, (III), IV, V, VI

Pump Tank: 1000 Gallons; PT 27 Date 10/16/98 System Description: Pressman. - Chamber ~~Stone~~ CNV

Pump Make: RED JACKET Model 1200 Serial No. 466 Repair System Description: Same CNV

Nitrification Field: No Fields 1 Square Feet ~~900~~ Linear Feet ~~300~~ Maintenance Agreement Required: ☐ Yes ☒ No

No Lines 4 Trench Width 36" Max Trench Bottom Depth 32" Gravel Depth SAND.

☒ House/Mod. Home No. Bedrooms 3

☐ Mobile Home No. Bathrooms 2

☐ Business No. Employees

☐ Other


☐ Slab ☐ Crawl Space ☒ Basement w/plumbing ☐ Basement wo/plumbing

Water Supply: ☒ Individual ☐ Public ☐ Community


Comments/Conditions: 25% reduction given. F 210 DRAINAGE WAY

Comments/Conditions:

INITIAL SITE SKETCH

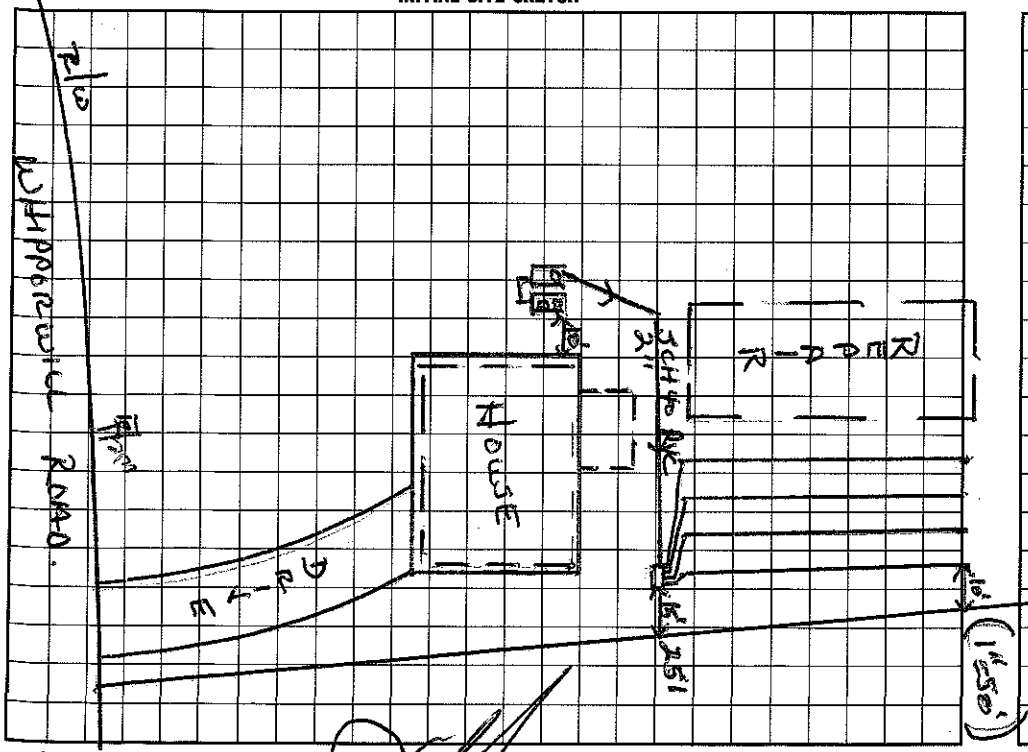

AS BUILT SKETCH

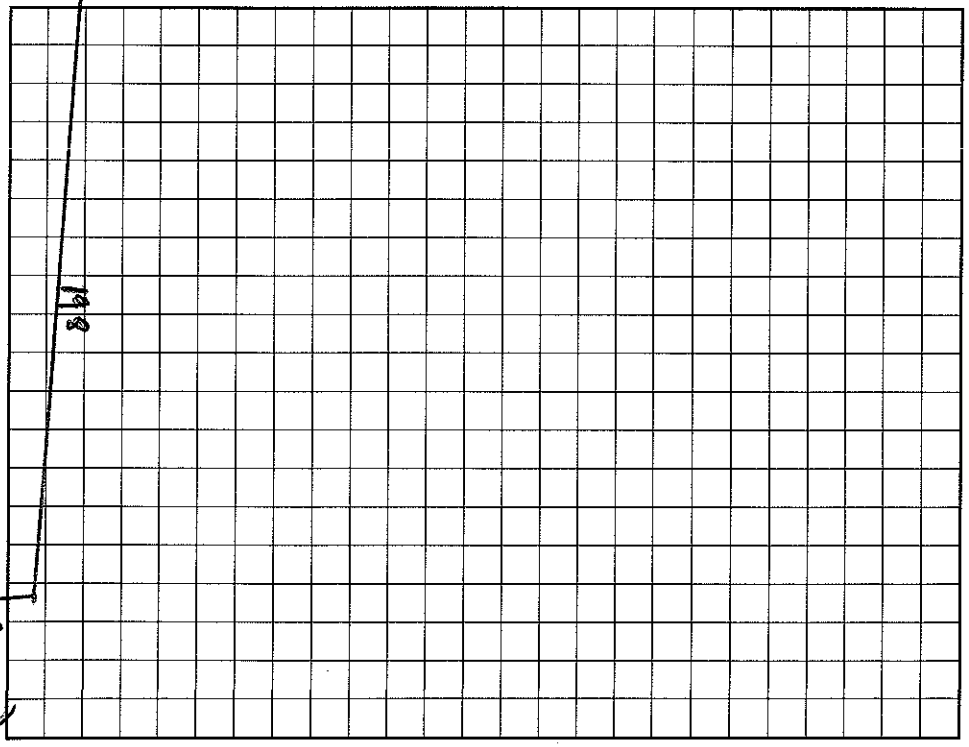

I understand that this permit can be suspended or revoked if any false information is supplied toward securing the permit/any unauthorized changes are made to the site/any unauthorized changes are made in the installation of the system. Improvement Permit with plat valid without expiration. Improvement Permit with site plan valid for sixty months. Authorization to Construct is valid for a period equal to that of Improvement Permit – not to exceed sixty months.

Signed: * date 12-9-98 Installed by: Reid Ensley

Improvement Permit by: date

Authorization to Construct by: Wesley Sparks RS. date 12/7/98 Operation Permit by: Wesley Sparks RS. date 3/10/99

Existing System Inspection by: date

HEALTH DEPT. COPY: WHITE INSPECTION COPY (FINAL): GREEN OWNER COPY (FINAL): YELLOW INSPECTION COPY (INITIAL): PINK OWNER COPY (INITIAL): GOLD