IREDELL COUNTY HEALTH DEPARTMENT

STATESVILLE 704-878-5305 MOORESVILLE 704-664-5281

IMPROVEMENT PERMIT / AUTHORIZATION TO CONSTRUCT / OPERATION PERMIT / EXISTING SYSTEM INSPECTION

PERMIT# 101394 PIN# 4637560239 DATE 7-19-2001

OWNER OR CONTRACTOR Bo of North Carolina PHONE: Business 489-4663 Diane Home

ADDRESS 5734 Hwy 150/P.O. Box 9254 Denver, NC 28037

LOCATION Hwy 150 W. TL Doolie Rd TR Purple Finch on left

SUBDIVISION Whippoorwill Woods BLOCK / SECTION 2 LOT 15 LOT AREA SITE CLASS. PS DESIGN FLOW 360gpd L.T.A.R. .3

Septic Tank: 1000 Gallons; STB 794 Date 2/8/00

Pump Tank: Gallons; PT Date

Pump Make: Model Serial No.

Nitrification Field: No Fields 1 Square Feet 400-600' Linear Feet 200'

No Lines 4@50' Trench Width 24" Max Trench Bottom Depth ≤30" Gravel Depth N/A

☒ New System ☐ Repair System Type: I, II, (III), IV, V, VI

System Description: Gravity - Panel Block*

Repair System Description: Panel Block

Maintenance Agreement Required: ☐ Yes ☒ No

☐ House/Mod. Home ☐ Mobile Home ☐ Business ☐ Other

No. Bedrooms No. Bathrooms No. Employees

☐ Slab ☐ Crawl Space ☐ Basement w/plumbing ☐ Basement wo/plumbing


Water Supply: ☒ Individual ☐ Public ☐ Community

Comments:/Conditions: Keep Septic System at least 10' from PL, 5' from House & 50' to any well. Well must be at least 50' from Septic & 25' from house. 50ft = 11 panels

Comments:/Conditions: * 50% reduction in Drainfield area.

Scale 1:50

INITIAL SITE SKETCH AS BUILT SKETCH

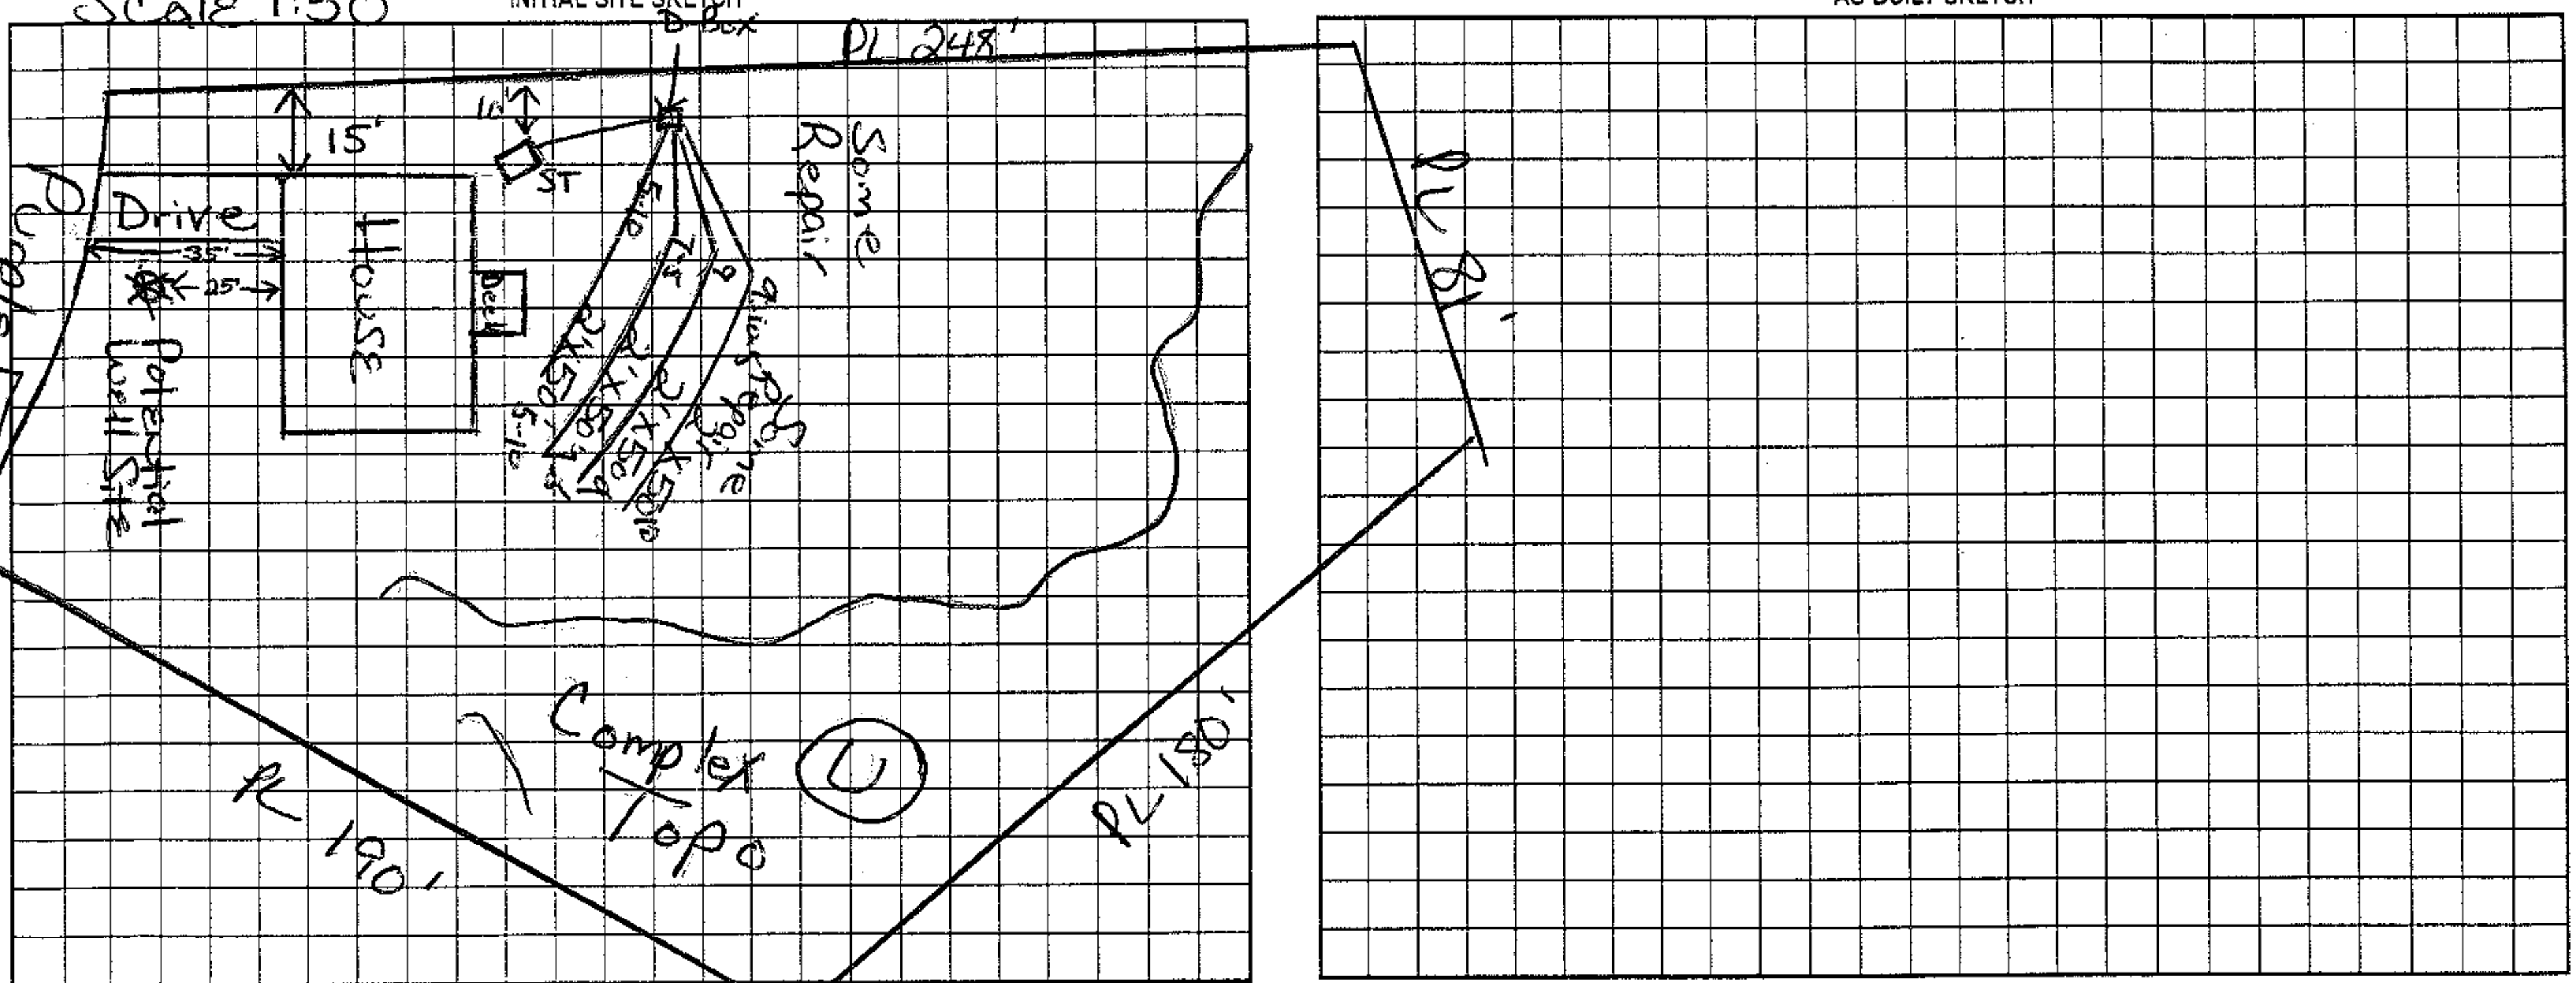

Permit can be suspended or revoked if any false information is supplied toward securing the permit/any unauthorized changes are made to the site/any unauthorized changes are made in the installation of the system. Improvement Permit with plat valid without expiration. Improvement Permit with site plan valid for sixty months. Authorization to Construct is valid for a period equal to that of Improvement Permit – not to exceed sixty months.

Signed: X Diane Laudlau date 7-2001 Installed by: Tim Ammons

Improvement Permit by: Maria H. H. Dobson RS date 7/19/2001 Operation Permit by: Wesley Sparks R.S. date 10/8/01

Authorization to Construct by: Maria H. H. Dobson RS date 7/19/2001 Existing System Inspection by: date

HEALTH DEPT. COPY: WHITE OWNER COPY (FINAL): YELLOW OWNER COPY (INITIAL): PINK