IREDELL COUNTY HEALTH DEPARTMENT

STATESVILLE 704-878-5305 MOORESVILLE 704-664-5281

IMPROVEMENT PERMIT / AUTHORIZATION TO CONSTRUCT / OPERATION PERMIT / EXISTING SYSTEM INSPECTION

PERMIT# 18195 PIN# Pt of 2PC 15 4637561763

OWNER OR CONTRACTOR Ray Short DATE 10/1/00

ADDRESS 476 Stutts Rd. Mooresville NC. PHONE: Business 309-7711 Home

LOCATION 150 W TL Deaton Rd TR Purple Finch on (R) before cul de sac.

SUBDIVISION Whippoorwill Woods BLOCK / SECTION 2 LOT 8 LOT AREA ~36,000 FT² SITE CLASS. PS DESIGN FLOW 360 L.T.A.R. .3

Septic Tank: 1000 Gallons; STB Date

Pump Tank: Gallons; PT Date

Pump Make: Model Serial No.

Nitrification Field: No Fields Square Feet 342 Linear Feet 114

No Lines 3 Trench Width 60" Max Trench Bottom Depth 36' ~~Gravel Depth~~ SAND

☐ New System ☒ Repair System Type: I, II, (III), IV, V, VI

System Description:

Repair System Description: CH PLASTIC Bed.

Maintenance Agreement Required: ☐ Yes ☒ No

☒ House/Mod. Home No. Bedrooms 3

☐ Mobile Home No. Bathrooms 2

☐ Business No. Employees

☐ Other

☐ Slab ☒ Crawl Space ☐ Basement w/plumbing ☐ Basement wo/plumbing


Water Supply: ☐ Individual ☐ Public ☐ Community

Comments:/Conditions:

Comments:/Conditions:

INITIAL SITE SKETCH

AS BUILT SKETCH

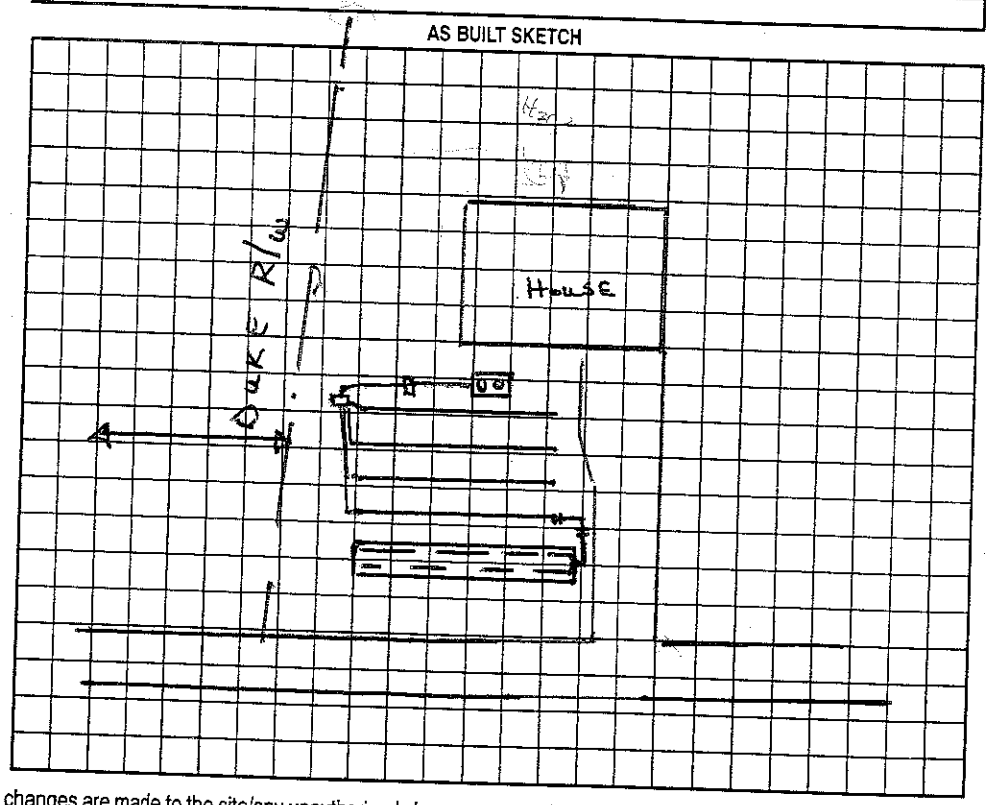

Permit can be suspended or revoked if any false information is supplied toward securing the permit/any unauthorized changes are made to the site/any unauthorized changes are made in the installation of the system. Improvement Permit with plat valid without expiration. Improvement Permit with site plan valid for sixty months. Authorization to Construct is valid for a period equal to that of Improvement Permit – not to exceed sixty months.

Signed: date

Improvement Permit by: date

Authorization to Construct by: date

Installed by: F.T. Ervin

Operation Permit by: Wesley Sparks R.S. date 9/29/00

Existing System Inspection by: date

HEALTH DEPT. COPY: WHITE OWNER COPY (FINAL): YELLOW OWNER COPY (INITIAL): PINK

IREDELL COUNTY HEALTH DEPARTMENT

STATESVILLE 704-878-5305 MOORESVILLE 704-664-5281

IMPROVEMENT PERMIT / AUTHORIZATION TO CONSTRUCT / OPERATION PERMIT / EXISTING SYSTEM INSPECTION

PERMIT# 18195 PIN# pt of 2PC15 DATE 4/23/99

OWNER OR CONTRACTOR RAY SHORT PHONE: Business Home

ADDRESS PO Box 49 ~~STATESVILLE~~

LOCATION ~~150~~ 150 W TL DOOLIE RD - TR PURPLE FENCH - ON RT

SUBDIVISION INNISWOOD WOODS BLOCK / SECTION 2 LOT 8 LOT AREA 30,000 sf SITE CLASS. OS DESIGN FLOW 350 L.T.A.R. 3

Septic Tank: 1000 Gallons; STB 794 Date 8/21/79
Pump Tank: Gallons; PT Date
Pump Make: Model Serial No.
Nitrification Field: No Fields 1 Square Feet 400 Linear Feet 200
No Lines 4@50' Trench Width ~~2'~~ 3' Max Trench Bottom Depth 36" Gravel Depth N/A

☑ New System ☐ Repair System Type: I, II, (III), IV, V, VI
System Description: GRAVITY PANEL
Repair System Description: Pump PANEL
Maintenance Agreement Required: ☐ Yes ☑ No


☑ House/Mod. Home No. Bedrooms 3
☐ Mobile Home No. Bathrooms 2
☐ Business No. Employees
☐ Other
☐ Slab ☑ Crawl Space ☐ Basement w/plumbing ☐ Basement wo/plumbing

Water Supply: ☑ Individual ☐ Public ☐ Community


Comments:/Conditions:

Comments:/Conditions: 57' x 6' - Ch. PANELS
Tank Pump - Filter Cleaned.

INITIAL SITE SKETCH 1"=100'

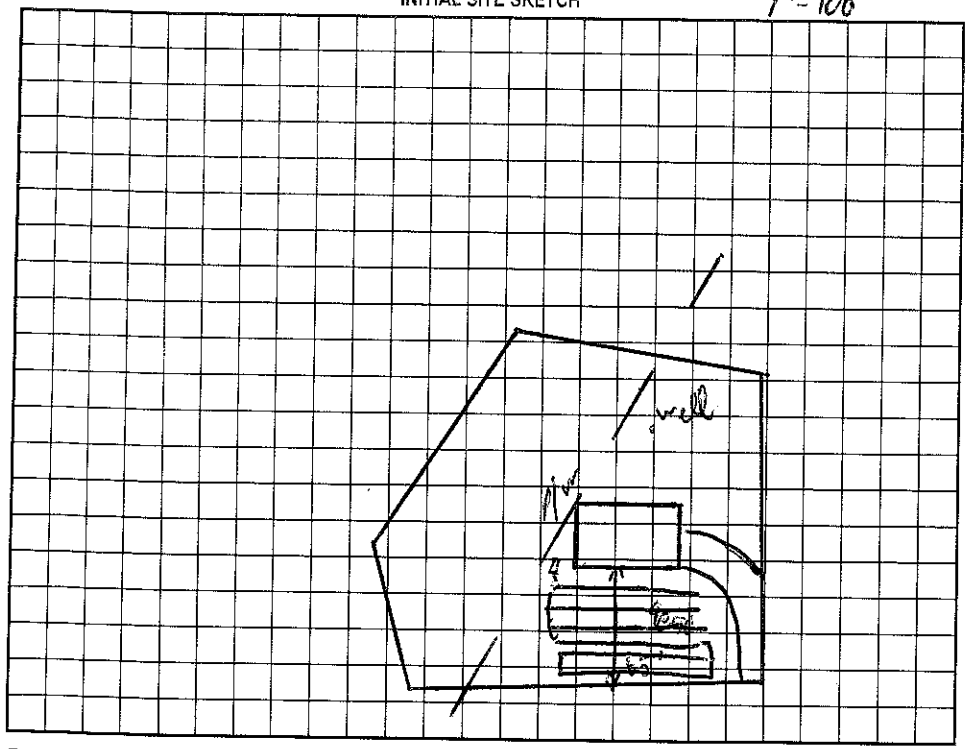

AS BUILT SKETCH

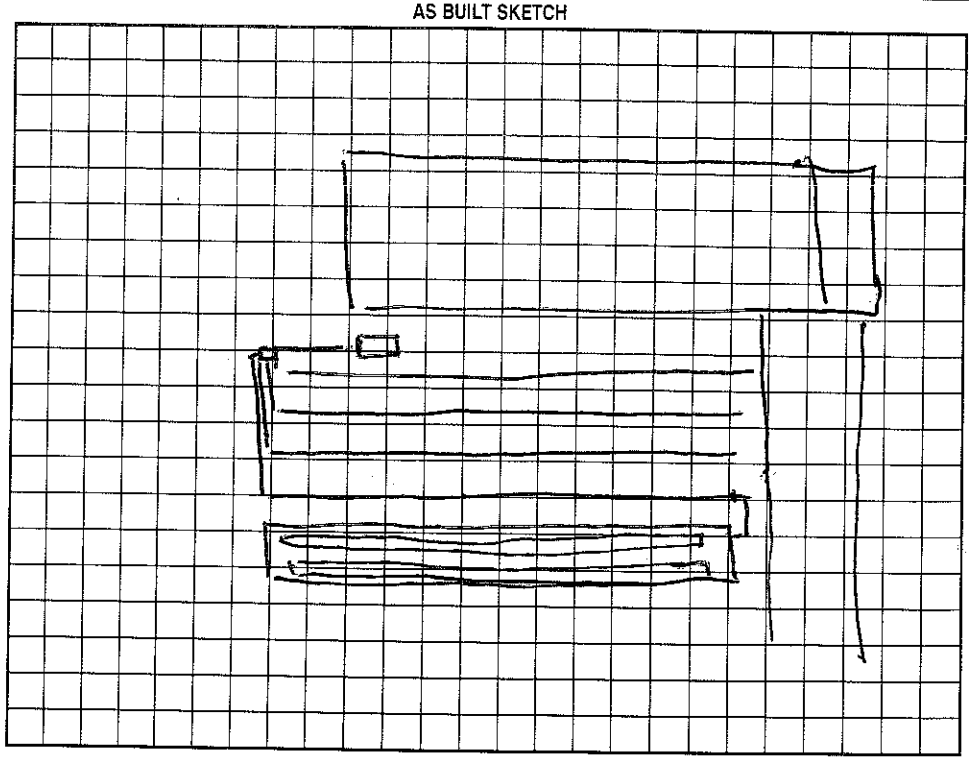

Permit can be suspended or revoked if any false information is supplied toward securing the permit/any unauthorized changes are made to the site/any unauthorized changes are made in the installation of the system. Improvement Permit with plat valid without expiration. Improvement Permit with site plan valid for sixty months. Authorization to Construct is valid for a period equal to that of Improvement Permit – not to exceed sixty months.

Signed: date

Improvement Permit by: EHS date 4/23/99

Authorization to Construct by: EHS date 4/23/99

Installed by: FJ Erwin

Operation Permit by: Wesley Sparks EHS date 10/18/99

Existing System Inspection by: date

HEALTH DEPT. COPY: WHITE OWNER COPY (FINAL): YELLOW OWNER COPY (INITIAL): PINK